

WASHINGTON
A-75
8-5-71

MISSISSIPPI
BOARD OF WATER COMMISSIONERS
416 North State Street
Jackson, Mississippi 39201

WATER WELL DRILLERS LOG

CODED
county well located

5 Aug 71 19 Lambert Drilling Co. date well completed firm name

LANDOWNER:
M.B. Cone
Hwy 4 N. Greenville, Miss.
(mailing address)

description of formations encountered	from to	
mixed.	0	15

WELL LOCATION:
sec. 32 T. 19 N R. 8 E
3 miles N. of Greenville
(distance) (direction) (nearest town)

sand & gravel	15	140
clay	140	210
clay & sand	210	360

WELL PURPOSE: home
(home, irrigation, municipal, industrial)

sand, blight.	360	370
---------------	-----	-----

WELL COMPLETION DATA:

(1) diameter (inches) 2 1/2

(2) total depth (feet) 430

(3) static water level (feet) 63 below top of ground.

(4) casing galv. 420 (material) (depth)
if telescope see back. (size)

(5) screen 10 430-420 (length) (depth to top)
2 1/2 S.S. (size) (material)

(6) pump 1 900/hy. (HP) (yield gpm)
Elect. 15gpm (type power)

(7) electric log no (yes or no)
(organization running log)

(8) how well bottom plugged
each well

sand, fine.	370	405
sand, good.	405	440


Aug 13 1971

CODED
MISS. BD. OF WATER COMM.

DRILLERS REMARKS:

If well telescopes please sketch and show depths.

GROUND LEVEL

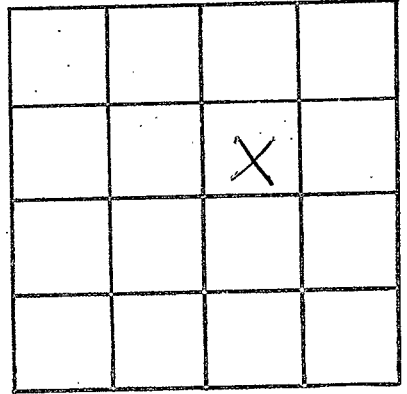

SECTION 32

Please indicate well location X.

ADDITIONAL INFORMATION

If more than one screen,
show locations of each on sketch.