

WASHINGTON
A 79
10-5-71

MISSISSIPPI
BOARD OF WATER COMMISSIONERS
416 North State Street
Jackson, Mississippi 39201

CODED

WATER WELL DRILLERS LOG

5 Oct 71 19 date well completed Lambert Drilling Wash firm name county well located

LANDOWNER: Mr. Rhodes.
Hwy 1 N.
Greenville, Miss.
(mailing address)

WELL LOCATION:
sec. 20 T. 19 N. R. 8 W.
4 miles N. of Greenville
(distance) (direction) (nearest town)

WELL PURPOSE: Home.
(home, irrigation, municipal, industrial)

- WELL COMPLETION DATA:
- (1) diameter (inches) 4 X 2
 - (2) total depth (feet) 503
 - (3) static water level (feet) 123 below top of ground.
 - (4) casing galv (material), 483 (depth)
 - 4 X 2 (size) if telescope see back.
 - (5) screen 20 (length), 503-483 (depth to top)
 - 2 1/2 (size), SS (material)
 - (6) pump 1 (HP), 20 (yield gpm)
 - Elect (type power)
 - (7) electric log (yes or no)
 - (organization running log)
 - (8) how well bottom plugged Back w/ 5/8" valve

description of formations encountered	from	to
Clay	0	30
sand.	30	70
sand & gravel	70	98
Clay	98	175
Clay & sand str.	175	390
sand, tight str. clay.	390	480
sand, good	480	510


CODED

OCT 22 1971

MISSISSIPPI BOARD OF WATER COMMISSIONERS
STATE OF MISSISSIPPI
WATER RESOURCES DIVISION

DRILLERS REMARKS:

If well telescopes please sketch and show depths.

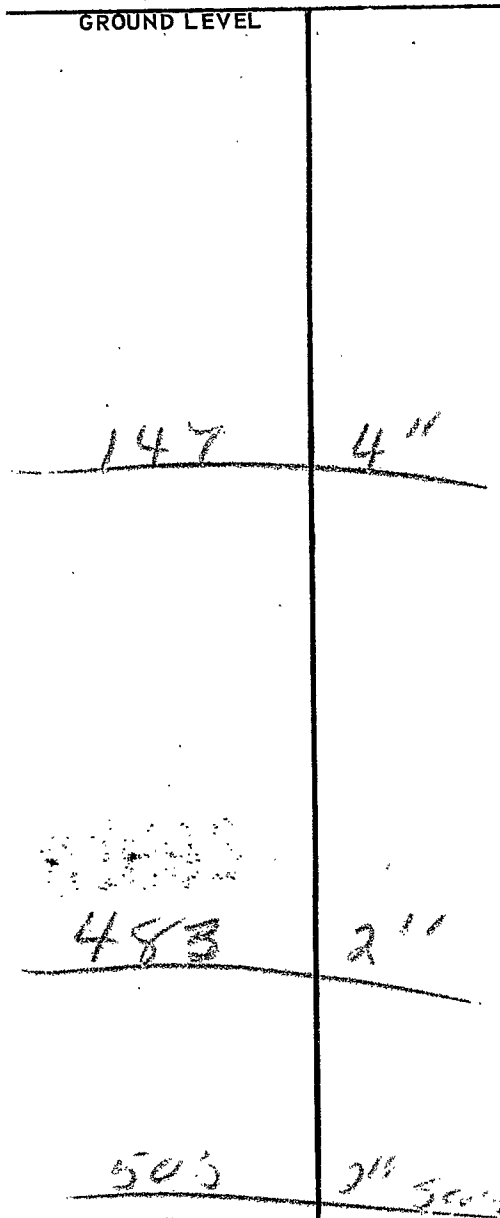

X			o

SECTION 20

Please indicate well location X.

ADDITIONAL INFORMATION

If more than one screen, show locations of each on sketch.