

WASHINGTON
A 82
5-6-72

MISSISSIPPI
BOARD OF WATER COMMISSIONERS
416 North State Street
Jackson, Mississippi 39201

CODED

WATER WELL DRILLERS LOG

6 May 72 19 Lambert Drilling Co. Wash
date well completed firm name county well located

LANDOWNER: V.C. Hammett
Greenville, Miss.

(mailing address)

WELL LOCATION:
sec. 10 T. 19 N R. 8 E
S W
10 miles N of Greenville
(distance) (direction) (nearest town)

WELL PURPOSE: home
(home, irrigation, municipal, industrial)

description of formations encountered	from	to
mixed	0	15
clay	15	40
sand	40	75
sand & gravel	75	105
clay	105	195
sand & clay	195	280
clay	280	340
sand & clay s&g	340	460
sand	460	490
sand & gravel	490	530

- WELL COMPLETION DATA:
- (1) diameter (inches) 4 1/2
 - (2) total depth (feet) 530
 - (3) static water level (feet) 42 below above top of ground.
 - (4) casing PVC 510 (material) (depth)
4 1/2 (size) if telescope see back.
 - (5) screen 20 530-510 (length) (depth to top)
2" S.S. (size) (material)
 - (6) pump 1 20 (HP) (yield gpm)
elect (type power)
 - (7) electric log (yes or no)
 - (organization running log)
 - (8) how well bottom plugged back Wash

CODED

JUN 16 1972

MISS. ED. OF
WATER BOARD

DRILLERS REMARKS:


If well telescopes please sketch and show depths.

GROUND LEVEL

4' 14C

2' 510

1' 530

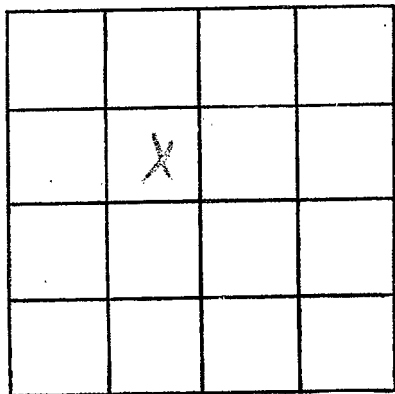

SECTION 10

Please indicate well location X.

ADDITIONAL INFORMATION

If more than one screen, show locations of each on sketch.