

WASHINGTON  
A83  
2-14-72

MISSISSIPPI  
BOARD OF WATER COMMISSIONERS  
416 North State Street  
Jackson, Mississippi 39201

**CODED**

WATER WELL DRILLERS LOG

2-14 date well completed  
1972 *W. Schulte Drilling* firm name  
Washington county well located

LANDOWNER:	description of formations encountered	from	to
Mr. P. M. Montgomery Sheenville, Miss (mailing address)	Clay Sand	0	18
WELL LOCATION: sec. 10 T. 19 N. R. 8 5 miles N of Bull (distance) (direction) (nearest town)	Clay Sand	141	170
WELL PURPOSE: (home, irrigation, municipal, industrial)	Clay	173	244
WELL COMPLETION DATA:	Sandy Shale	244	386
(1) diameter (inches) 4" x 2"	Sand	386	507
(2) total depth (feet) 499			
(3) static water level (feet) 27 below top of ground.			
(4) casing (material) (depth) (size) if telescope see back.			
(5) screen (length) (depth to top) (size) (material)			
(6) pump (HP) (yield gpm) (type power)			
(7) electric log (yes or no)			
(organization running log)			
(8) how well bottom plugged			
DRILLERS REMARKS:			


**CODED**

FEB 19 1972

MISSISSIPPI  
BOARD OF WATER COMMISSIONERS

If well telescopes please sketch and show depths.

GROUND LEVEL

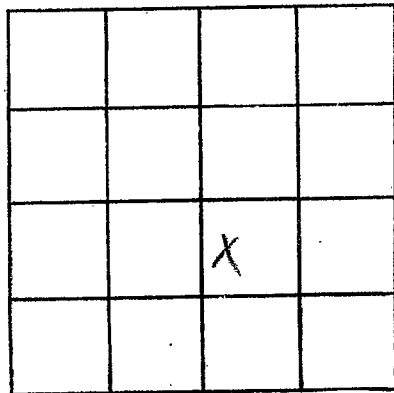

SECTION 10

Please indicate well location X.

ADDITIONAL INFORMATION

If more than one screen, show locations of each on sketch.