

WASHINGTON  
A86  
8-18-72

MISSISSIPPI  
BOARD OF WATER COMMISSIONERS  
416 North State Street  
Jackson, Mississippi 39201

**CODED**

WATER WELL DRILLERS LOG

8-18-72 date well completed  
OWENS Plumbing Wash. firm name  
county well located

LANDOWNER: Floyd DANTLER

RI, BOX 544

description of formations encountered	from	to
	top soil	0
Shard + gravel	60	170
clay	170	317
sand	317	497

GREENVILLE MISS. 38721 (mailing address)

WELL LOCATION:

sec. 20 T. 14 S. R. 8 E  
3 miles N. of G. VILLE  
(distance) (direction) (nearest town)

WELL PURPOSE:

(home, irrigation, municipal, industrial)

WELL COMPLETION DATA:

- (1) diameter (inches) 4"
- (2) total depth (feet) 497'
- (3) static water level (feet) 51 below top of ground.
- (4) casing (material) Galv. (depth) 487'
- NO if telescope see back. (size)
- (5) screen (length) 10' (depth to top) 497'
- 2" (size) S-S. (material)
- (6) pump 1 (HP) (yield gpm)
- E/Fect. (type power)
- (7) electric log NO (yes or no)

**CODED**

AUG 30 1972

(organization running log)


(8) how well bottom plugged S-B

MISS. BD. OF WATER COMMISSIONERS

DRILLERS REMARKS: OWENS

If well telescopes please sketch and show depths.

GROUND LEVEL

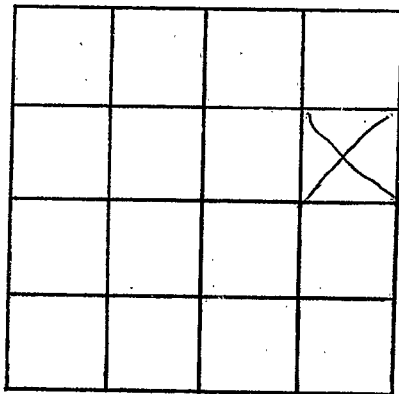

SECTION \_\_\_\_\_

Please indicate well location X.

ADDITIONAL INFORMATION

If more than one screen,  
show locations of each on sketch.