

WASHINGTON

A 88

8-16-72

MISSISSIPPI BOARD OF WATER COMMISSIONERS
416 North State Street
Jackson, Mississippi 39201

CODED

WATER WELL DRILLERS LOG

16 Aug 72
date well completed

Lambert Drilling Co Wash
firm name

county well located

LANDOWNER:	description of formations encountered	from	to
Louis Moore Greenville Miss (mailing address)			
WELL LOCATION: sec 29 T 19 N R 8 E 4 miles N of Greenville (distance) (direction) (nearest town)	Sand	15	65
WELL PURPOSE: domestic (home, irrigation, municipal, industrial)	Sand & gravel	65	98
WELL COMPLETION DATA: (1) diameter (inches) 4x2 (2) total depth (feet) 505 (3) static water level (feet) 62 below above top of ground. (4) casing PVC, 485, (material) (depth) 4x2 (size) if telescope see back. (5) screen 20', 405-485 (length) (depth to top) 2' PVC (size) (material) (6) pump 1 (HP) 19 (yield gpm) Elect. (type power) (7) electric log (yes or no) (organization running log) (8) how well bottom plugged backwash valve	clay	98	141
	Rock	141	142
	clay	142	192
	Rock	192	193
	clay & sandst	193	315
	Sand	315	330
	sand st. clay	330	465
	sand good	465	505
DRILLERS REMARKS:			

CODED

NOV - 3 1972

MISSISSIPPI BOARD OF WATER COMMISSIONERS

If well telescopes please sketch and show depths.

GROUND LEVEL

140

4"

345

2"


485

20

2"

Screen 1

505

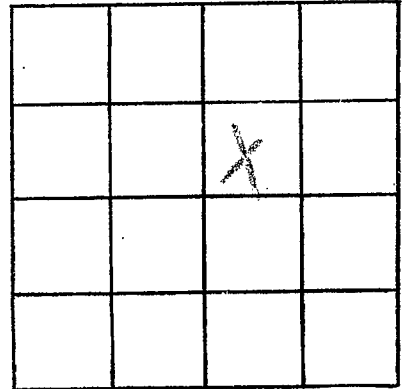

SECTION 27

Please indicate well location X.

ADDITIONAL INFORMATION

If more than one screen, show locations of each on sketch.