

WASHINGTON
A 90
6-15-73

MISSISSIPPI
BOARD OF WATER COMMISSIONERS
416 North State Street
Jackson, Mississippi 39201

CODED

WATER WELL DRILLERS LOG

6-15 1973 Bailey Drilling Co. Washington
date well completed firm name county well located

LANDOWNER: Metcalf & Weather
Greenville
Miss.
(mailing address)

description of formations encountered	from	to
	<u>Clay Sand</u>	<u>8</u> <u>10</u>

WELL LOCATION:
sec. 36 T. 19 N R. 8
5 miles NE of Greenville
(distance) (direction) (nearest town)

WELL PURPOSE: Farm
(home, irrigation, municipal, industrial)

CODED

- WELL COMPLETION DATA:
- (1) diameter (inches) 2"
 - (2) total depth (feet) 62
 - (3) static water level (feet) 13 below top of ground.
 - (4) casing Steel, 57,
(material) (depth)
____ if telescope see back.
(size)
 - (5) screen 5', 57
(length) (depth to top)
2", Stainless Steel
(size) (material)
 - (6) pump 1, 21
(HP) (yield gpm)
Electric
(type power)
 - (7) electric log No
(yes or no)

(organization running log)


(8) how well bottom plugged Back pressure valve

DRILLERS REMARKS:

MISSISSIPPI
JUN 18 1973

If well telescopes please
sketch and show depths.

GROUND LEVEL

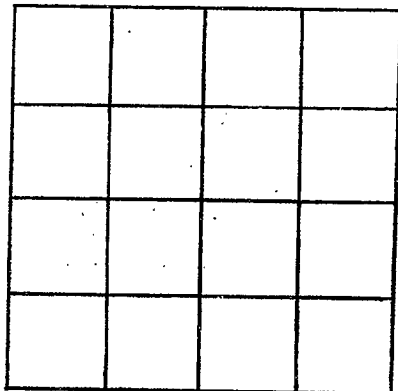

SECTION _____

Please indicate well location X.

ADDITIONAL INFORMATION

If more than one screen,
show locations of each on sketch.