

WASH
A 91
7-12-73

MISSISSIPPI
BOARD OF WATER COMMISSIONERS
416 North State Street
Jackson, Mississippi 39201

CODED

WATER WELL DRILLERS LOG

7-12 19 73 Lin County Farmers Assn. Washington
date well completed firm name county well located

LANDOWNER: Delta Land Co.
South, Miss.

description of formations encountered

from to

<u>sand - top sand</u>	<u>0</u>	<u>6.5</u>
<u>sand</u>	<u>6.5</u>	<u>26.0</u>
<u>sand & gravel</u>	<u>26.0</u>	<u>52.0</u>
<u>sand white</u>	<u>52.0</u>	<u>65</u>
<u>sand & coarse gravel</u>	<u>65</u>	<u>110.5</u>

(mailing address)

WELL LOCATION:

(?) 17 sec 27 T 19 N R 8 E
S W
3 miles North of Preville
(distance) (direction) (nearest town)

WELL PURPOSE: Irrigation
(home, irrigation, municipal, industrial)

WELL COMPLETION DATA:

- (1) diameter (inches) 6"
- (2) total depth (feet) 110.5
- (3) static water level (feet) 25 below above top of ground.
- (4) casing Black Pipe, 62.5
(material) (depth)
6" If telescope see back.
(size)
- (5) screen 48', 62.5
(length) (depth to top)
6", Steel Reinforced
(size) (material)
- (6) pump Waco, 800
(HP) (yield gpm)
Inactor
(type power)
- (7) electric log N.
(yes or no)

CODED

(organization running log)

(8) how well bottom plugged filled


OCT 20 1973

DRILLERS REMARKS:

MISS. B. OF
WATER

If well telescopes please sketch and show depths.

GROUND LEVEL

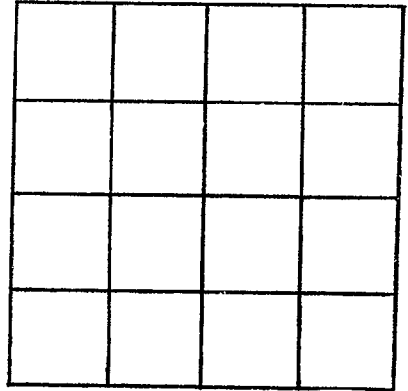

SECTION _____

Please indicate well location X.

ADDITIONAL INFORMATION

If more than one screen, show locations of each on sketch.