

WASH.
A 92
3-4-74

MISSISSIPPI
BOARD OF WATER COMMISSIONERS
416 North State Street
Jackson, Mississippi 39201

CODED

WATER WELL DRILLERS LOG

3/4 1974 Bailey Drilling Co Washington
date well completed firm name county well located

LANDOWNER: Howard Brent
Winterville
Miss
(mailing address)


description of formations encountered	from	to
Clay	0	10
Sand	10	65
Gravel	65	102
Mud	102	280
Sand	280	338
Mud	338	390
Sand	390	483

WELL LOCATION:
sec. 18 T. 19 N R. 9 E
S W
3 miles west of Winterville
(distance) (direction) (nearest town)

WELL PURPOSE: Home
(home, irrigation, municipal, industrial)

- WELL COMPLETION DATA:
- (1) diameter (inches) 4X3X2 1/2
 - (2) total depth (feet) 483
 - (3) static water level (feet) 51 below above top of ground.
 - (4) casing Steel, 463,
(material) (depth)
4X3 if telescope see back.
(size)
 - (5) screen 20', 463
(length) (depth to top)
2 1/2", Stainless Steel
(size) (material)
 - (6) pump 5, 60
(HP) (yield gpm)
Electric
(type power)
 - (7) electric log No
(yes or no)

CODED

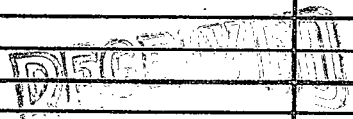

MAR 13 1974

MISS. BD. OF WATER COMMISSIONERS

(organization running log)
(8) how well bottom plugged
back pressure valve

DRILLERS REMARKS:

If well telescopes please sketch and show depths.

GROUND LEVEL

15.9
200 3'
up to screen

	X		

SECTION 15

Please indicate well location X.

ADDITIONAL INFORMATION

If more than one screen, show locations of each on sketch.