

WASHINGTON
A94
8-1-74

MISSISSIPPI
BOARD OF WATER COMMISSIONERS
416 North State Street
Jackson, Mississippi 39201

CODED

WATER WELL DRILLERS LOG

8-1-1974 date well completed Owens Plumbing firm name Wash county well located

LANDOWNER: J. Dantzier
Rt. 1, Box 397
L. Velle ms. 38701
(mailing address)

description of formations encountered	from to	
	feet	feet
top soil	0	60
Sand & gravel	60	180
Clay mixed	180	243
Sand	243	399

WELL LOCATION:
sec. 9 T. 19 N. R. 5 W.
8 miles north of Gville
(distance) (direction) (nearest town)

WELL PURPOSE:
(home, irrigation, municipal, industrial)

- WELL COMPLETION DATA:
- (1) diameter (inches) 2"
 - (2) total depth (feet) 399
 - (3) static water level (feet) 18 below top of ground.
 - (4) casing Sub. 389 (material) (depth)
 - (size) If telescope see back.
 - (5) screen 10' 399 (length) (depth to top)
 - 2" SS- (size) (material)
 - (6) pump 1 55 (HP) (yield gpm)
 - Elec- (type power)
 - (7) electric log no (yes or no)
 - (organization running log)
 - (8) how well bottom plugged 5.13

CODED


REGISTERED
AUG 12 1974

DRILLERS REMARKS: OWENS

MISS. BD. OF WATER COMMISSIONERS

If well telescopes please sketch and show depths.

GROUND LEVEL

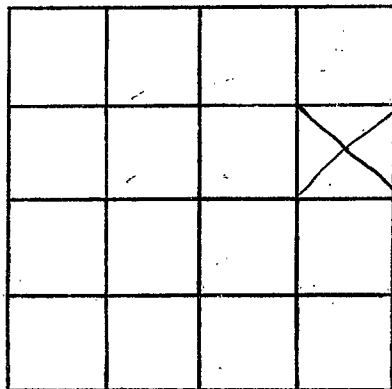

SECTION _____

Please indicate well location X.

ADDITIONAL INFORMATION

If more than one screen,
show locations of each on sketch.