

WASH.

A 96

5-20-74

MISSISSIPPI
BOARD OF WATER COMMISSIONERS
416 North State Street
Jackson, Mississippi 39201

CODED

WATER WELL DRILLERS LOG

20 May 1974
date well completed

Lambert Drilling Co.
firm name

Wash.
county well located

LANDOWNER:

Ciba.-Orga Chem. Co
Winterville, Miss.
(mailing address)

description of formations encountered

from

to

WELL LOCATION:

sec. 18 T-19 N R-8 E
5 miles N of Grenoville
(distance) (direction) (nearest town)

Mixed

0 30

Sand

30 70

Sand coarse

70 96

Pea gravel

90 105

Clay

105 160

WELL PURPOSE: Drinking
(home, irrigation, municipal, industrial)

Clay sand

150 308

Rock

308 310

WELL COMPLETION DATA:

- (1) diameter (inches) 4x3
- (2) total depth (feet) 540
- (3) static water level (feet) 52 below above top of ground.

Sand & clay

310 445

- (4) casing steel 510
(material) (depth)

Sand. cdk.

445 490

4x3 if telescope see back.
(size)

Sand. good.

490 550

- (5) screen 30' 540-576
(length) (depth to top)

2" S.S.
(size) (material)

- (6) pump 5 50
(HP) (yield gpm)


Elect.
(type power)

- (7) electric log
(yes or no)

(organization running log)

- (8) how well bottom plugged back wash

DRILLERS REMARKS:

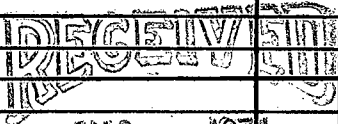

MAY - 8 1974

If well telescopes please sketch and show depths.

GROUND LEVEL

147

4"

3"

~~510~~

~~540~~

3" 5/8"

			X

SECTION 18

Please indicate well location X.

ADDITIONAL INFORMATION

If more than one screen, show locations of each on sketch.