

WASHINGTON
A 97
8-30-74

MISSISSIPPI
BOARD OF WATER COMMISSIONERS
416 North State Street
Jackson, Mississippi 39201

CODED

WATER WELL DRILLERS LOG

Aug 30 - 1974 Owens Pkg. & Mfg. Wash.
date well completed firm name county well located

LANDOWNER: Boise S. Mallonay Boy
183 Mitchell Ave. MS. 38760
(mailing address)

description of formations encountered	from	to
top soil	0	27
Sand	27	153
Clay	158	195
Sand & gravel	195	342
Sand	342	482

WELL LOCATION:
sec 34 T 14 R 8 W
5 miles NE of Evville
(distance) (direction) (nearest town)

WELL PURPOSE: Home
(home, irrigation, municipal, industrial)

WELL COMPLETION DATA:

- (1) diameter (inches) 2"
- (2) total depth (feet) 482'
- (3) static water level (feet) 40 below above top of ground.
- (4) casing Sand 472'
(material) (depth)
- (size) if telescope see back.
- (5) screen 10 472'
(length) (depth to top)
- 2" S.S.
(size) (material)
- (6) pump 1 20
(HP) (yield gpm)
- Electric
(type power)
- (7) electric log (yes or no) _____
- (organization running log) _____
- (8) how well bottom plugged SB-


DISCOVERED
AND
SEP 22 1974

MISS. BD. OF WATER COMMISSIONERS

DRILLERS REMARKS: Owens

If well telescopes please sketch and show depths.

GROUND LEVEL

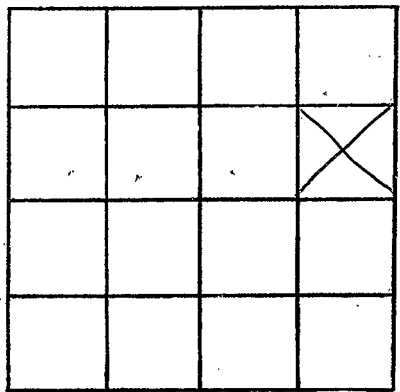

SECTION 8

Please indicate well location X.

ADDITIONAL INFORMATION

Lined area for additional information.

If more than one screen, show locations of each on sketch.