

WASH.
A 98
11/8/74

MISSISSIPPI
BOARD OF WATER COMMISSIONERS
416 North State Street
Jackson, Mississippi 39201

CODED

WATER WELL DRILLERS LOG

11/8 1974 Dutton Well Supply Co Washington
date well completed firm name county well located

LANDOWNER:
E. R. Stingray
Greenwell, Miss.
(mailing address)

WELL LOCATION:
sec. 17 T. 19 N. R. 9 E
4 miles SW of Greenwell
(distance) (direction) (nearest town)

WELL PURPOSE: Private
(home, irrigation, municipal, industrial)

WELL COMPLETION DATA:

(1) diameter (inches) 4 1/2
(2) total depth (feet) 548
(3) static water level (feet) 60 below above top of ground.
(4) casing gal. pipe (material) / (depth)
If telescope see back.
(5) screen 20 ft (length) / (depth to top)
2" (size) / stainless steel (material)
(6) pump 1 (HP) / 25 (yield gpm)
Chas (type power)
(7) electric log no (yes or no)
(organization running log)
(8) how well bottom plugged R-F Valve

| description of formations encountered | from | to |
|---------------------------------------|------|-----|
| Clay | 0 | 43 |
| Fine sand | 43 | 90 |
| Harder clay gravel | 90 | 103 |
| Clay | 103 | 334 |
| Hard | 334 | 335 |
| Clay | 355 | 415 |
| Fine sand | 415 | 570 |
| Clay & shale | 508 | 508 |
| Clay | 508 | 572 |
| Clay | 572 | 567 |


DRILLERS REMARKS:

RECEIVED
NOV 26 1974

MISS. BD. OF WATER COMM

If well telescopes please sketch and show depths.

GROUND LEVEL

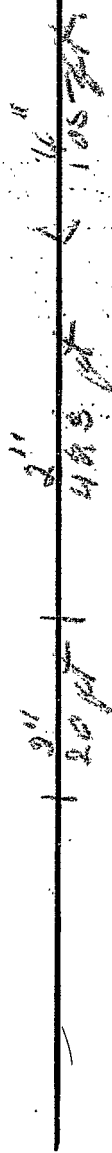

| | | | |
|--|--|--|--|
| | | | |
| | | | |
| | | | |
| | | | |

SECTION 17

Please indicate well location X.

ADDITIONAL INFORMATION

If more than one screen, show locations of each on sketch.