

WASH.
A 100
2-29-75

MISSISSIPPI
BOARD OF WATER COMMISSIONERS
416 North State Street
Jackson, Mississippi 39201

CODED

WATER WELL DRILLERS LOG

2/24 1975 Bailey Dr. Co. Washington
date well completed firm name county well located

LANDOWNER: Frank Koestler
Greenville, Miss.

description of formations encountered

from to

Clay	0	25
Sand	25	80
Gravel	80	100
Mud	100	390
Sand	390	440

(mailing address)

WELL LOCATION:

sec. 32 T 19 N R 8 E
& W
4 miles N of Greenville
(distance) (direction) (nearest town)

WELL PURPOSE: Home
(home, irrigation, municipal, industrial)

CODED

WELL COMPLETION DATA:

- (1) diameter (inches) 4 X 2
- (2) total depth (feet) 440
- (3) static water level (feet) 58 below top of ground.
- (4) casing Steel 430 (material) (depth)
4 X 2 if telescope see back. (size)
- (5) screen 10' 430' (length) (depth to top)
2" Stainless steel (size) (material)
- (6) pump 1 20 (HP) (yield gpm)
Electric (type power)
- (7) electric log No (yes or no)
(organization running log)

RECEIVED
FEB 27 1975


(8) has well bottom plugged
Back pressure Valve

MISS. BU. OF WATER COMM.

DRILLERS REMARKS:

If well telescopes please sketch and show depths.

GROUND LEVEL

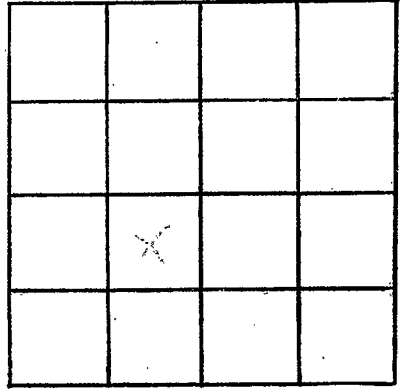

SECTION _____

Please indicate well location X.

ADDITIONAL INFORMATION

165' 0"

147' 0"

147' 0"

If more than one screen, show locations of each on sketch.