

Washington
 A 10P
 1-13-75

MISSISSIPPI
 BOARD OF WATER COMMISSIONERS
 416 North State Street
 Jackson, Mississippi 39201

CODED

WATER WELL DRILLERS LOG

1-13 1975 Schultz firm name Wash county well located

LANDOWNER: E. H. W. W.

description of formations encountered	from	to
	clay	0
sand	17	93
clay	93	146
sand	146	180
sandy shale	180	279
sand	279	310
clay	310	404
sand	404	475

Winterville Miss
 (mailing address)

WELL LOCATION:

sec. 7 T. 19 N R. 8 E 151
 4 miles N of Cvl
 (distance) (direction) (nearest town)

WELL PURPOSE: Home
 (home, irrigation, municipal, industrial)

WELL COMPLETION DATA:

- (1) diameter (inches) 2"
- (2) total depth (feet) 470
- (3) static water level (feet) 46 below top of ground.
- (4) casing P.V.C. 460 (material) (depth)
- (size) if telescope see back.
- (5) screen 10 (length) (depth to top)
- 2" P.V.C. (size) (material)
- (6) pump 10 (HP) 1000 (yield/gpm)
- Electric (type power)
- (7) electric log No (yes or no)
- (organization running log)
- (8) how well bottom plugged Special


DRILLERS REMARKS:

MISSISSIPPI
 DEPARTMENT OF WATER RESOURCES
 JUN 2 1975

MISS. BU. OF WATER COMMISSIONERS

If well telescopes please sketch and show depths.

GROUND LEVEL

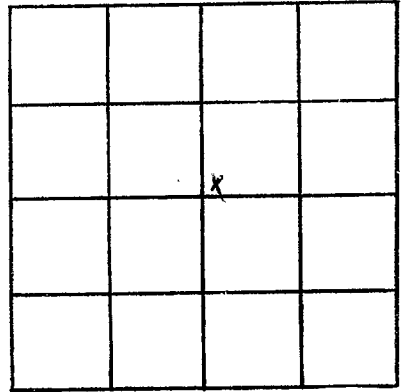

SECTION 4

Please indicate well location X.

ADDITIONAL INFORMATION

If more than one screen,
show locations of each on sketch.