

Washington  
 A 102  
 8-4-75

MISSISSIPPI  
 BOARD OF WATER COMMISSIONERS  
 416 North State Street  
 Jackson, Mississippi 39201

CODED

WATER WELL DRILLERS LOG


8-4 1975 Bailey Drilling Co. Washington  
 date well completed firm name county well located

LANDOWNER:	description of formations encountered	from	to
Jeff Wilkerson Winterville Miss. (mailing address)	Clay	0	18
	Sand	18	95
	Gravel	95	100
	Mud	100	235
	Rock	235	235 1/2
	Mud	235 1/2	500
	Sand + Mud	500	540
	Sand	540	582
WELL LOCATION: sec. 8 T 19 N R 8 E 15 S 2 miles N of Winterville (distance) (direction) (nearest town)			
WELL PURPOSE: Home (home, irrigation, municipal, industrial)			
WELL COMPLETION DATA:			
(1) diameter (inches) 4 X 2			
(2) total depth (feet) 582			
(3) static water level (feet) 55 below top of ground.			
(4) casing Steel 562 (material) (depth) 4 X 2 if telescope see back. (size)			
(5) screen 20' 562 (length) (depth to top) 2" stainless steel (size) (material)			
(6) pump 2 35 (HP) (yield gpm) Electric (type power)			
(7) electric log no (yes or no)			
(organization running log)			
(8) how well bottom plugged back pressure valve			
DRILLERS REMARKS:			

RECEIVED  
 DRILLING DIV  
 AUG 4 1975

If well telescopes please sketch and show depths.

GROUND LEVEL

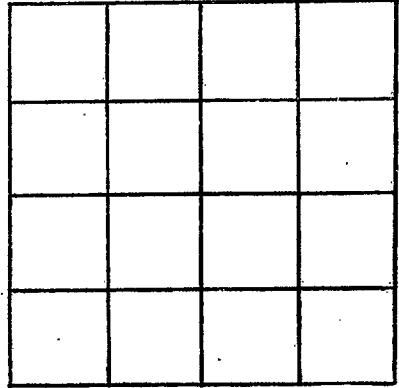

SECTION \_\_\_\_\_

Please indicate well location X.

ADDITIONAL INFORMATION

If more than one screen, show locations of each on sketch.