

WASHINGTON

A 105

5-26-77

MISSISSIPPI  
 BOARD OF WATER COMMISSIONERS  
 416 North State Street  
 Jackson, Mississippi 39201

WATER WELL DRILLERS LOG

CODED

Washington

5-26  
date well completed

1977 Schultz Drilling Co  
firm name

county well located

LANDOWNER:

A. J. CORREDO

Hwy 1. South

Greenville

(mailing address)

description of formations encountered

from

to

clay

0 52

sand

52 103

clay

103 180

starry shale

180 470

sand

470 490

WELL LOCATION:

sec. 19 T. 19 N. R. 8 E. W. 7

7 miles north of Greenville

(distance)

(direction)

(nearest town)

WELL PURPOSE:

home

(home, irrigation, municipal, industrial)

CODED

WELL COMPLETION DATA:

(1) diameter (inches) 4 in x 2 1/2

(2) total depth (feet) 490

(3) static water level (feet) 22 below top of ground.

(4) casing PVC 460 (material) (depth)

(size) if telescope see back.

(5) screen 30 460 (length) (depth to top)

2 1/2 PVC (size) (material)

(6) pump 3 50 (HP) (yield gpm)

(type power)

(7) electric log NO (yes or no)

(organization running log)

(8) how well bottom plugged b/w

DRILLERS REMARKS:


RECEIVED

NOV 8 0 1977

MISS. BD. OF WATER COMM

If well telescopes please  
sketch and show depths.

GROUND LEVEL

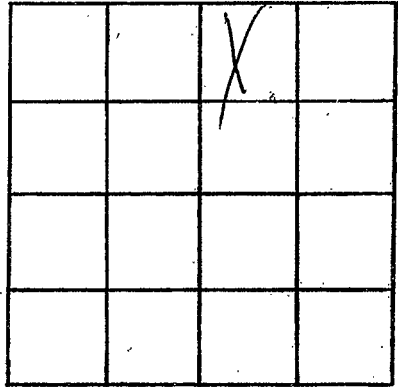

SECTION \_\_\_\_\_

Please indicate well location X.

ADDITIONAL INFORMATION

If more than one screen,  
show locations of each on sketch.