

WASH.
A 106
10/25/79

MISSISSIPPI
BOARD OF WATER COMMISSIONERS
416 North State Street
Jackson, Mississippi 39201

CODED

WATER WELL DRILLERS LOG

10/25 1979 Coporate Drilling Inc. Washington
date well completed firm name county well located

LANDOWNER: Alan K. Kinton
R1 Box 185
Greenville Ms
(mailing address)

WELL LOCATION:
sec. 12 T. 19 N. R. 8 E.
2 miles South of Princeton
(distance) (direction) (nearest town)

WELL PURPOSE: Home + Shop
(home, irrigation, municipal, industrial)

- WELL COMPLETION DATA:
- (1) diameter (inches) 4 3/8
 - (2) total depth (feet) 540
 - (3) static water level (feet) 419' below top of ground.
 - (4) casing gal 540
(material) (depth)
4 3/8 if telescope see back.
(size)
 - (5) screen 20' 520
(length) (depth to top)
3' steel
(size) (material)
 - (6) pump 5 5
(HP) (yield gpm)
electric
(type power)
 - (7) electric log NONE
(yes or no)

(organization running log)
 - (8) how well bottom plugged
back, jets out valve

description of formations encountered	from	to
clay	0	20
sand	20	25
gravel + sand	25	105
blue mud	105	225
fine sand + mud	225	260
mud	260	451
mud	451	492
mud	492	500
rock	500	503
mud	503	510
sand	510	510

CODED

DEPT. OF NATURAL RESOURCES
BUREAU OF LAND & WATER RESOURCES


NOV 30 1979

RECEIVED

DRILLERS REMARKS:

If well telescopes please sketch and show depths.

GROUND LEVEL

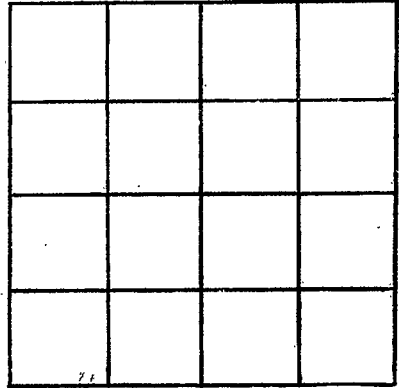

SECTION _____

Please indicate well location X.

ADDITIONAL INFORMATION

If more than one screen,
show locations of each on sketch.