

A108  
 WASHINGTON  
 8-1-80

MISSISSIPPI  
 BOARD OF WATER COMMISSIONERS  
 416 North State Street  
 Jackson, Mississippi 39201

CODED

WATER WELL DRILLERS LOG

Aug. 1-80 19 Owens Pkg. Washington  
 date well completed firm name county well located

LANDOWNER:  
 RUTH H. BRENT  
 Route #3 Box 595  
 (mailing address)

WELL LOCATION:  
 sec. 20 T. 19 N. R. 8 E  
 5 miles N of GREENVILLE  
 (distance) (direction) (nearest town)

WELL PURPOSE:  
 (home irrigation, municipal, industrial)

- WELL COMPLETION DATA:
- (1) diameter (inches) 4 x 2"
  - (2) total depth (feet) 480'
  - (3) static water level (feet) 19 below top of ground.
  - (4) casing PVC, 450' (material) (depth)
  - NO If telescope see back. (size)
  - (5) screen 30' 480' (length) (depth to top)
  - 2" PVC (size) (material)
  - (6) pump 1 12 (HP) (yield gpm)
  - Elec. (type power)
  - (7) electric log NO (yes or no)
  - (organization running log)
  - (8) how well bottom plugged 3/8

description of formations encountered	from	to
top soil	0	19'
sand	19	60'
clay	60	140'
sand	140	190
clay	190	225
sand	225	255
clay	255	315
sand	315	480

CODED


DEPT. OF NATURAL RESOURCES  
 BUREAU OF LAND & WATER RESOURCES

RECEIVED  
 AUG 29 1980

DRILLERS REMARKS:  
 Owens

If well telescopes please sketch and show depths.

GROUND LEVEL

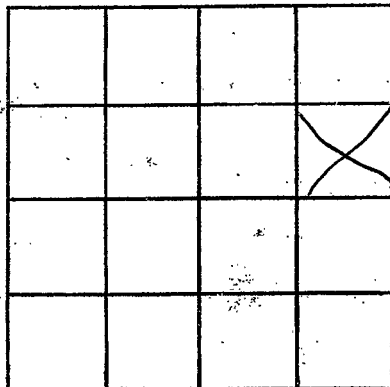

SECTION *X-20*

Please indicate well location X.

ADDITIONAL INFORMATION

If more than one screen,  
show locations of each on sketch.