

MISSISSIPPI DEPARTMENT OF NATURAL RESOURCES

Bureau of Land and Water Resources

Southport Mall

P.O. Box 10631

Jackson, Mississippi 39209

CODED

WATER WELL DRILLERS LOG

Washington
A 114
5/14/81
1st May 1981
date well completed

Lambert Drilling
firm name

Wash
county well located

LANDOWNER:	description of formations encountered	from	to
Forkland Pitt.			
Greenville, Miss. (mailing address)	mixed	0	10
WELL LOCATION:	Clay blue	0	85
sec. 3 T. 19(N) S. R. 8 E. (W)	gravel & sand	85	110
10 miles N/E of Green. (distance) (direction) (nearest town)	Clay blue	110	205
WELL PURPOSE:	Clay & sand	205	345
(home, irrigation, municipal, industrial)	Sand, med.	345	420
WELL COMPLETION DATA:	Sand	420	490
(1) diameter (inches) 4x2			
(2) total depth (feet) 480			
(3) static water level (feet) 46 below top of ground.			
(4) casing PVC, 460, (material) (depth)			
4x2 (size) if telescope see back.			
(5) screen 20, 480-460 (length) (depth to top)			
2 (size) PVC (material)			
(6) pump 1 (HP) 20 (yield gpm)			
elect (type power)			
(7) electric log no (yes or no)			
n (organization running log)			
(8) how well bottom plugged			
ball press.			

CODED

DEPT. OF NATURAL RESOURCES
BUREAU OF LAND & WATER RESOURCES

MAY 18 1981

RECEIVED

DRILLERS REMARKS:

If well telescopes please sketch and show depths.


GROUND LEVEL

140 4"

460 2"

480 2" SCV,

If more than one screen, show locations of each on sketch.

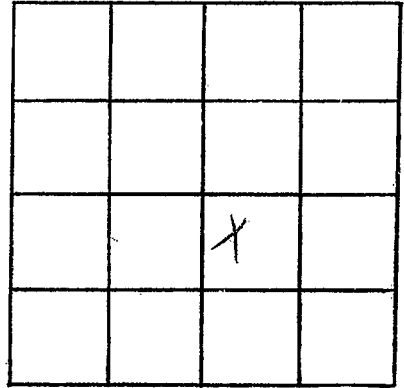

SECTION 3

Please indicate well location X.

ADDITIONAL INFORMATION

Lined area for additional information.