

Washington  
 #115  
 4-25-81

MISSISSIPPI  
 BOARD OF WATER COMMISSIONERS  
 416 North State Street  
 Jackson, Mississippi 39201

WATER WELL DRILLERS LOG

4-25-81 1981 IRRIGATION WELL & SUPPLY, Inc WASHINGTON  
 date well completed firm name county well located

LANDOWNER: DELTA PIPE LAND

CODED


PROUDENTIAL INS. CO.  
 P.O. BOX 4899  
 GREENVILLE, MS 38701  
 (mailing address)

description of formations encountered	from	to
TOP SOIL CLAY	0	10
CLAY	10	20
FINE SAND	20	30
" "	30	40
COARSE SAND	40	50
" "	50	60
COARSE SAND - GRAVEL	60	70
" "	70	80
" "	80	90
" "	90	98

WELL LOCATION:  
 sec. 26 T19 N R17 E  
 S W  
 6 miles N of G'VILLE  
 (distance) (direction) (nearest town)

WELL PURPOSE: IRRIGATIONAL  
 (home, irrigation, municipal, industrial)


- WELL COMPLETION DATA:
- (1) diameter (inches) 16"
  - (2) total depth (feet) 98'
  - (3) static water level (feet) 20' below top of ground
  - (4) casing 16" (material) 58' (depth)
  - (size) if telescope see back.
  - (5) screen 40' (length) 58'-98' (depth to top)
  - 16" (size) METAL (material)
  - (6) pump 250 (HP) 4,000 (yield gpm)
  - DIESEL (type power)
  - (7) electric log NO (yes or no)
  - (organization running log)
  - (8) how well bottom plugged WELDED PLATE

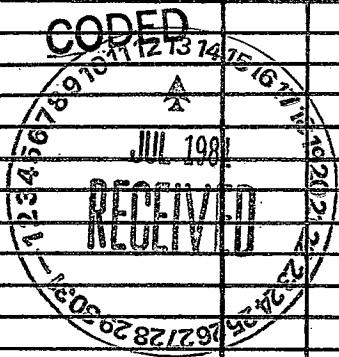

DRILLERS REMARKS:

If well telescopes please sketch and show depths.

GROUND LEVEL

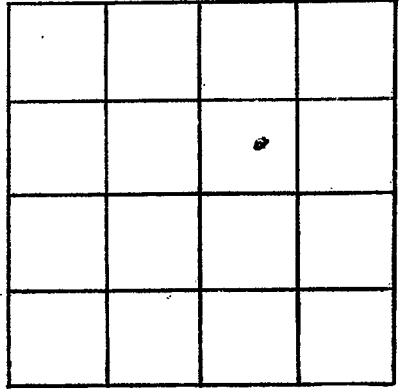

SECTION 26

Please indicate well location X.

ADDITIONAL INFORMATION

If more than one screen,  
show locations of each on sketch.