

Washington  
 #116  
 4-22-81

MISSISSIPPI  
 BOARD OF WATER COMMISSIONERS  
 416 North State Street  
 Jackson, Mississippi 39201

WATER WELL DRILLERS LOG

4-22-81 date well completed  
 IRRIGATION WELL + SUPPLY, INC. firm name  
 WASHINGTON county well located


LANDOWNER: DELTA FINE LAND  
PRUDENTIAL INS. CO.  
P.O. Box 4699  
GREENVILLE, MS 38701  
 (mailing address)

WELL LOCATION:  
 sec. 26 T 19 N R 7 E  
6 miles N of GREENVILLE  
 (distance) (direction) (nearest town)

WELL PURPOSE: IRRIGATION  
 (home, irrigation, municipal, industrial)

- WELL COMPLETION DATA:
- (1) diameter (inches) 16"
  - (2) total depth (feet) 98'
  - (3) static water level (feet) 20' below top of ground.
  - (4) casing 16" (material) 58' (depth)
  - \_\_\_\_\_ if telescope see back. (size)
  - (5) screen 40' (length) 58'-98' (depth to top)
  - 16' (size) METAL (material)
  - (6) pump 100 (HP) 1800 (yield gpm)
  - DIESEL (type power)
  - (7) electric log NO (yes or no)
  - \_\_\_\_\_ (organization running log)
  - (8) how well bottom plugged WELDED PLATE


description of formations encountered	CODED	from	to
TOP SOIL + CLAY		0	10
CLAY		10	20
FINE SAND		20	30
" "		30	40
COARSE SAND		40	50
" "		50	60
COARSE SAND + GRAVEL		60	70
" " "		70	80
" " "		80	90
" " "		90	98

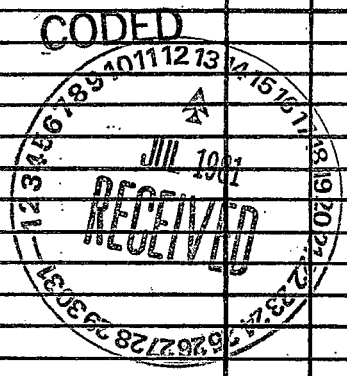

DRILLERS REMARKS:

If well telescopes please sketch and show depths.

GROUND LEVEL

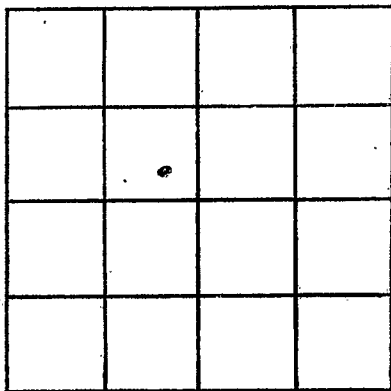

SECTION 26

Please indicate well location X.

ADDITIONAL INFORMATION

If more than one screen, show locations of each on sketch.