

Washington
 A 117
 3-23-81

MISSISSIPPI
 BOARD OF WATER COMMISSIONERS
 416 North State Street
 Jackson, Mississippi 39201

WATER WELL DRILLERS LOG

3/23 date well completed 1981 Irrigation Wells Supply Wash. firm name county well located

LANDOWNER: HARLEY MITCHELL

description of formations encountered	CODED	
	from	to
CLAY	0	25
FINE SAND	25	50
sand course	50	65
GRAVEL	65	95

(mailing address)

WELL LOCATION:
 sec 35 T 19 N R 8 E
 S W
 4 miles NE of Goulet
 (distance) (direction) (nearest town)

WELL PURPOSE: IRRIGATION
 (home, irrigation, municipal, industrial)

- WELL COMPLETION DATA:
- (1) diameter (inches) 16"
 - (2) total depth (feet) 95'
 - (3) static water level (feet) _____ below above top of ground.
 - (4) casing STEEL 57' (material) (depth)
 16" (size) If telescope see back.
 - (5) screen 28' 57' (length) (depth to top)
 (size) (material)
 - (6) pump 60 3000 (HP) (yield gpm)
 DIESEL (type power)
 - (7) electric log No (yes or no)
 (organization running log)
 - (8) how well bottom plugged PLATE

CODED

DEPT. OF NATURAL RESOURCES
 BUREAU OF LAND & WATER RESOURCES


APR 14 1981

RECEIVED

DRILLERS REMARKS:

If well telescopes please sketch and show depths.

GROUND LEVEL

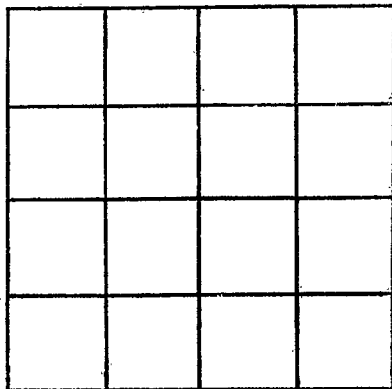

SECTION _____

Please indicate well location X.

ADDITIONAL INFORMATION

If more than one screen,
show locations of each on sketch.