

Washington

~~Butler~~

CL-2136 **A122**

4/16/82

GW 5219

43

**MISSISSIPPI
BOARD OF WATER COMMISSIONERS
416 North State Street
Jackson, Mississippi 39201**

CODED

WATER WELL DRILLERS LOG

Washington
~~Butler~~

4-16 19 **82** **LAYNE CENTRAL CO.** **Washington**
date well completed firm name county well located

LANDOWNER:
CHARLES SPEAKES
BENOIT, MS
(mailing address)

WELL LOCATION:
sec. 3 T 19 N R 8 7 W
6 miles NE of Greenville
(distance) (direction) (nearest town)

description of formations encountered	from	to
clay	0	22
coarse sand	22	42
coarse sand	42	52
coarse sand/pea gravel	52	72
coarse sand/pea gravel	72	82
coarse sand/gravel	82	99
clay	99	

WELL PURPOSE:
(home, irrigation, municipal, industrial)

WELL COMPLETION DATA:

(1) diameter (inches) 32"

(2) total depth (feet) 99'

(3) static water level (feet) 25' below top of ground.

(4) casing steel 59' (material), (depth), 16" (size) if telescope see back.

(5) screen 40' 59' (length), (depth to top). 16" st. steel (size), (material)

(6) pump 60 (HP) 2500 (yield gpm) electric (type power)

(7) electric log no (yes or no)

(organization running log) st. plate

(8) how well bottom plugged

CODED

DEPT. OF NATURAL RESOURCES
BUREAU OF LAND & WATER RESOURCES


JUN 24 1982

RECEIVED

DRILLERS REMARKS:

If well telescopes please sketch and show depths.

GROUND LEVEL

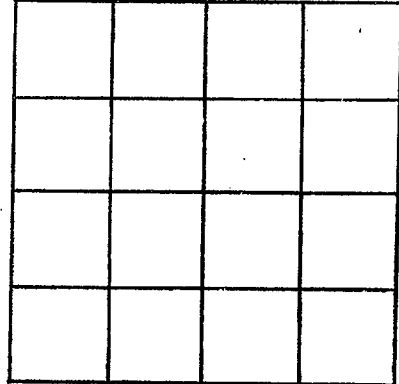

SECTION _____

Please indicate well location X.

ADDITIONAL INFORMATION

A series of horizontal lines providing space for additional information.

If more than one screen, show locations of each on sketch.