

MISSISSIPPI DEPARTMENT OF NATURAL RESOURCES

Bureau of Land and Water Resources

Southport Mall

P.O. Box 10631

Jackson, Mississippi 39209

WATER WELL DRILLERS LOG

CODED

A123  
 Washington  
 10-25-83

10/25 1983  
 date well completed

Coppage Drilling  
 firm name

Wash  
 county well located

LANDOWNER: Bill Coppage  
RT3 Box 804  
Gville Ms  
 (mailing address)

description of formations encountered

from to

WELL LOCATION:  
 sec 32 T 19 R 8 E  
15 miles N of Gville  
 (distance) (direction) (nearest town)

Clay	0	18
Sand	18	65
Sand & gravel	65	102
Mud	102	280
Rock	280	280.5
Mud	280.5	480
Sand + Mud	480	560
fine sand	560	580
sand	580	635

WELL PURPOSE: Home  
 (home, irrigation, municipal, industrial)

WELL COMPLETION DATA:

(1) diameter (inches) 4 x 3 x 2 1/2

(2) total depth (feet) 630

(3) static water level (feet) 58 below above top of ground.

(4) casing STEEL 610  
 (material) (depth)

4 x 3 x 2 1/2 if telescope see back.  
 (size)

(5) screen 20' 610  
 (length) (depth to top)

2 1/2" STAINLESS  
 (size) (material)

(6) pump 5 85  
 (HP) (yield gpm)

ELECTRIC  
 (type power)

(7) electric log NO  
 (yes or no)

(organization running log)

(8) how well bottom plugged  
DRY WASH VALVE

DRILLERS REMARKS:  
SAND VERY tight


DEPT. OF NATURAL RESOURCES  
 BUREAU OF LAND & WATER RESOURCES

NOV 16 1983

RECEIVED

If well telescopes please sketch and show depths.

GROUND LEVEL

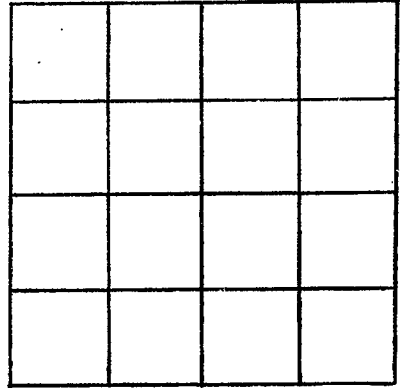

SECTION \_\_\_\_\_

Please indicate well location X.

ADDITIONAL INFORMATION

If more than one screen, show locations of each on sketch.