

MISSISSIPPI DEPARTMENT OF NATURAL RESOURCES
Bureau of Land and Water Resources
 Southport Mall
 P.O. Box 10631
 Jackson, Mississippi 39209
WATER WELL DRILLERS LOG

CODED

A 125
WASHINGTON
12-19-84

12-19-84 19 IRrigation Equipment WASHINGTON
 date well completed firm name county well located

LANDOWNER: Prudential Insurance
5050 Poplar Ave.
Memphis, TN 38119
#5 Hillis (mailing address)

description of formations encountered	from	to
<u>SAND</u>	<u>0</u>	<u>15</u>
<u>CLAY</u>	<u>15</u>	<u>30</u>
<u>FINE SAND</u>	<u>30</u>	<u>40</u>
<u>COARSE SAND</u>	<u>40</u>	<u>95</u>
<u>W/PEA GRAVEL</u>		

WELL LOCATION:
 sec. 27 T. 19 N. R. 8 E.
3 miles NE of Winkeville
 (distance) (direction) (nearest town)

WELL PURPOSE: IRrigation
 (home, irrigation, municipal, industrial)

WELL COMPLETION DATA:

(1) diameter (inches) 16"

(2) total depth (feet) 95'

(3) static water level (feet) 10' below above top of ground.

(4) casing steel 55'
 (material) (depth)

_____ if telescope see back.
 (size)

(5) screen 40' 55'
 (length) (depth to top)

16" steel
 (size) (material)

(6) pump 80 1200
 (HP) (yield gpm)

Diesel
 (type power)

(7) electric log NO
 (yes or no)

(organization running log) steel

(8) how well bottom plugged PLATE

CODED

MISSISSIPPI DEPARTMENT OF NATURAL RESOURCES
 BUREAU OF LAND & WATER RESOURCES


DEC 27 1984

RECEIVED

DRILLERS REMARKS:

If well telescopes please sketch and show depths.

GROUND LEVEL

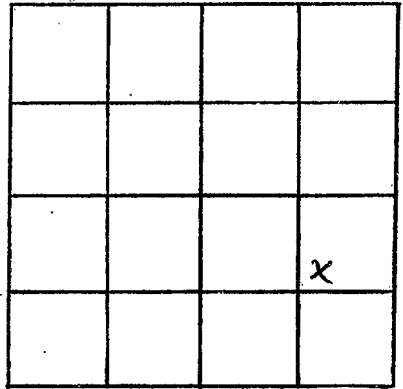

SECTION 27

Please indicate well location X.

ADDITIONAL INFORMATION

A series of horizontal lines for entering additional information.

If more than one screen, show locations of each on sketch.