

# MISSISSIPPI DEPARTMENT OF NATURAL RESOURCES

Bureau of Land and Water Resources

COUNTY WELL LOCATED	
Washington	
WELL NUMBER	CODED
A 131	
01-30-87	
DATE WELL COMPLETED	

PERMIT NUMBER
MS-GW-06679
NAME OF DRILLING FIRM
Larry's well & Pump

## CODED

P.O. Box 10631  
Jackson, Mississippi 39209  
WATER WELL DRILLERS LOG

NAME & MAILING ADDRESS OF LANDOWNER			
Luther B. Oakes, Jr.			
101 Karen street			
Greenville, MS 38701			
WELL LOCATION:	SEC	TOWNSHIP	RANGE
SE 1/4 NE 1/4	8	19 <sup>N</sup> <sub>S</sub>	8 <sup>E</sup> <sub>W</sub>
DISTANCE	DIRECTION	NEAREST TOWN	
1 Miles	East	of Winterville	
OTHER LANDMARK			
WELL PURPOSE: Home, <u>Irrigation</u> Municipal, Industrial, Fish Pond, etc.			

PUMP DATA			
PUMP TYPE (Circle One): Submersible, <u>Turbine</u> Jet Flowing Well, Other (Describe) _____			
POWER TYPE (Circle One): Electric, Tractor, <u>Diesel</u> Gasoline, Butane, Other (Describe) _____			
Pump Capacity (GPM)	No. of Stages	Setting Depth	
3000	1	60 FT.	
PUMP TEST <u>None</u>			
Well yielded _____ GPM with a drawdown of <u>CODED</u> ft. after _____ hours of pumping			

WELL DATA		
Well Depth	Casing Diameter (In.)	Casing Length (Ft.)
102	16"	62
Type of Casing	Hole Depth	Depth to Static Water Level
Steel	102	16'
TYPE OF COMPLETION: (Circle One or More): <u>Gravel Packed</u> Underreamed, Telescoped, Natural Development, Open Hole, Other		
Top of Lap Pipe or Reduction in Casing		
FEET	IF TELESCOPED OR MORE THAN ONE SCREEN: USE BACK PAGE	

LOG DATA	
TYPE OF LOG RUN (Circle One): Electric, Gamma Ray, Density, Sonic, <u>No Log Run</u> , Neutron, Other (Describe) _____	
Name of Organization Running Log	

SCREEN DATA		
Diameter - Inches	Length - Feet	Slot Size - Inches
16"	40	1060
Screen Type	Depth to Bottom - Feet	
Steel	102	


GEOLOGIC DATA (Office Use Only)			
Surface Elev.	Geologic Unit	Unit Thickness	Depth to Top
Subs. SWL	Date	Analysis	Aquifer Test

Driller's Remarks	

DESCRIPTION OF FORMATIONS ENCOUNTERED	FROM	TO	FORMATIONS (Continued)	FROM	TO
clay	0	30	<h1 style="font-size: 3em; opacity: 0.5;">RECEIVED</h1> MAR 24 1987		
fine sand	30	50			
med sand	50	75			
coarse sand & gravel	75	102			
Department of Natural Resources Bureau of Land & Water Resources					
IF MORE SPACE IS NEEDED, USE BACK					

If well telescopes please sketch and show depths.

GROUND LEVEL

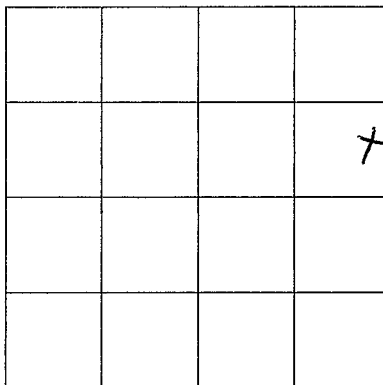

SECTION \_\_\_\_\_

Please indicate well location X. 8

ADDITIONAL INFORMATION

If more than one screen, show location of each on sketch.