

MISSISSIPPI DEPARTMENT OF NATURAL RESOURCES

Bureau of Land and Water Resources

Southport Mall

P.O. Box 10631

Jackson, Mississippi 39209

WATER WELL DRILLERS LOG

TAP  
88187-CMG  
03 A134  
CODED

7-7 date well completed

88 Dyer Well firm name

Washington county well located

LANDOWNER

Ralph Owens

description of formations encountered

from

to

Box 100  
Methale Ms.  
(mailing address)

Clay	0	20
7 Sand & Clay	20	38
7 Sand	38	48
7 Sand & Gravel	48	60
7 Sand	60	72
7 Sand & Gravel	72	87
7 Sand & Gravel	87	98
7 Sand & Gravel	98	102

WELL LOCATION:

sec 26 T 19 N R 8 E  
2 miles NE of Methale  
(distance) (direction) (nearest town)

WELL PURPOSE: Irrigation  
(home, irrigation, municipal, industrial)

WELL COMPLETION DATA:

- (1) diameter (inches) 16"
- (2) total depth (feet) 102'
- (3) static water level (feet) \_\_\_\_\_ below above top of ground.
- (4) casing steel (material) (depth) 16" If telescope see back. (size)
- (5) screen 40' (length) (depth to top) 16" (size) (material)
- (6) pump 40 (HP) (yield gpm) Gear (type power)
- (7) electric log No (yes or no) None (organization running log)
- (8) how well bottom plugged Plate

RECEIVED


JUL 11 1988

Department of Natural Resources  
Bureau of Land & Water Resources

DRILLERS REMARKS:

If well telescopes please sketch and show depths.

GROUND LEVEL

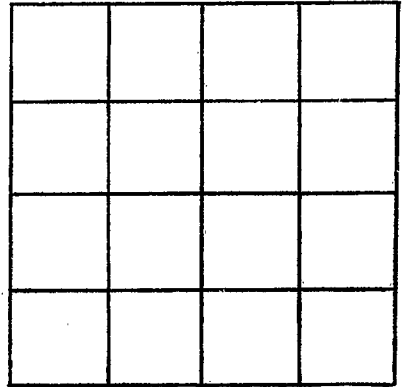

SECTION \_\_\_\_\_

Please indicate well location X.

ADDITIONAL INFORMATION

If more than one screen, show locations of each on sketch.