

MISSISSIPPI DEPARTMENT OF NATURAL RESOURCES

Bureau of Land and Water Resources

Southport Mall

P.O. Box 10631

Jackson, Mississippi 39209

WATER WELL DRILLERS LOG

TEP
88187-CMG
-02 A135
CODED

7-8 1988 Dyer Well Washington
date well completed firm name county well located

LANDOWNER: Ralph Owens
P.O. Box 100
Metcalf Ms 38760
(mailing address)

description of formations encountered	from	to
Clay	0	28
F Sand	28	38
F Sand + Gravel	38	42
Fine Sand	42	78
Clay	78	82
Fine Sand	82	88
F Sand + Gravel	88	90
M Sand + Gravel	90	95
Sand + Gravel	95	100
F Sand + Gravel	100	102
M Sand + Gravel	102	110

WELL LOCATION:
sec. 26 T 19 N R 8 W
8 miles (distance) of Metcalf (direction) (nearest town)

WELL PURPOSE: Irrigation
(home, irrigation, municipal, industrial)

WELL COMPLETION DATA:

- (1) diameter (inches) 16"
- (2) total depth (feet) 110'
- (3) static water level (feet) _____ below top of ground.
- (4) casing steel (material) _____ (depth) _____
16" (size) if telescope see back.
- (5) screen 40 (length) _____ (depth to top) _____
16 (size) _____ (material)
- (6) pump 30 (HP) _____ (yield gpm) _____
Gear (type power)
- (7) electric log No (yes or no)
None (organization running log)
- (8) how well bottom plugged Plate


RECEIVED
JUL 15 1988

Department of Natural Resources
Bureau of Land & Water Resources

DRILLERS REMARKS:

If well telescopes please sketch and show depths.

GROUND LEVEL

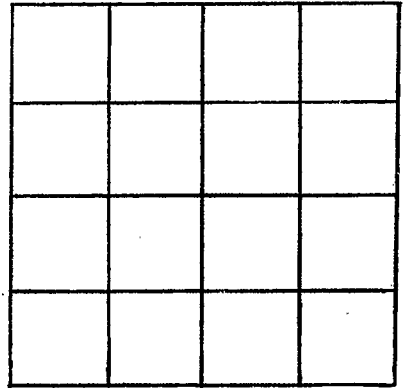

SECTION _____

Please indicate well location X.

ADDITIONAL INFORMATION

If more than one screen,
show locations of each on sketch.