

MISSISSIPPI DEPARTMENT OF NATURAL RESOURCES

Bureau of Land and Water Resources

| | |
|--|---|
| COUNTY WELL LOCATED Wash | |
| WELL NUMBER A137 | CODED <input checked="" type="checkbox"/> |
| DATE WELL COMPLETED 10 June 88 | |

| |
|--|
| PERMIT NUMBER |
| NAME OF DRILLING FIRM Lambert Drilling |

P.O. Box 10631
Jackson, Mississippi 39209
WATER WELL DRILLERS LOG

| | | | |
|--|-----------|------------------------|-----------------------|
| NAME & MAILING ADDRESS OF LANDOWNER Bill Pagne | | | |
| W. in Terrell, Miss. | | | |
| WELL LOCATION: SEC TOWNSHIP RANGE | | | |
| | 6 | 19 ^N | 8 ^W |
| DISTANCE | DIRECTION | NEAREST TOWN | |
| 3 Miles | n | of Wilder | |
| OTHER LANDMARK | | | |
| WELL PURPOSE: Home <input checked="" type="radio"/> Irrigation Municipal, Industrial, Fish Pond, etc. | | | |

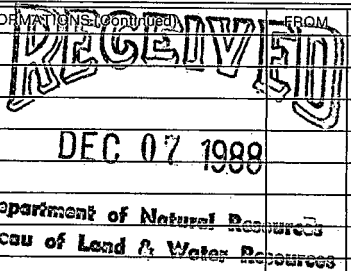
| | | | |
|---|---------------|---------------|--|
| PUMP DATA | | | |
| PUMP TYPE (Circle One): <input checked="" type="radio"/> Submersible, Turbine, Jet Flowing Well, Other (Describe) _____ | | | |
| POWER TYPE (Circle One): <input checked="" type="radio"/> Electric, Tractor, Diesel, Gasoline, Butane, Other (Describe) _____ | | | |
| Pump Capacity (GPM) | No. of Stages | Setting Depth | |
| 1100 | 3 | 60 FT. | |
| PUMP TEST | | | |
| Well yielded 1100 GPM with a drawdown of 20 ft. after 3 hours of pumping | | | |

| | | |
|--|------------------------------------|--|
| WELL DATA | | |
| Well Depth 105 | Casing Diameter (In.) 10 | Casing Length (Ft.) 65 |
| Type of Casing PVC | Hole Depth 105 | Depth to Static Water Level 12 |
| TYPE OF COMPLETION: (Circle One or More): <input checked="" type="radio"/> Gravel Packed, Underreamed, Telescoped, <input type="radio"/> Natural Development, Open Hole, Other (Describe) _____ | | |
| Top of Lap Pipe or Reduction in Casing | | |
| FEET IF TELESCOPED OR MORE THAN ONE SCREEN: USE BACK PAGE | | |

| | |
|---|--|
| LOG DATA | |
| TYPE OF LOG RUN (Circle One): No Log Run, Electric, Gamma-Ray, Density, Sonic, Neutron, Other (Describe) _____ | |
| Name of Organization Running Log | |

| | | |
|--------------------------------|---|---------------------------------|
| SCREEN DATA | | |
| Diameter - Inches 10 | Length - Feet 46 | Slot Size - Inches 30 |
| Screen Type PVC | Depth to Bottom - Feet 105-65 | |

| | | | |
|---------------------------------|---------------|----------------|--------------|
| GEOLOGIC DATA (Office Use Only) | | | |
| Surface Elev. | Geologic Unit | Unit Thickness | Depth to Top |
| Subs. SWL | Date | Analysis | Aquifer Test |
| Driller's Remarks | | | |
| | | | |

| DESCRIPTION OF FORMATIONS ENCOUNTERED | FROM | TO | FORMATIONS ENCOUNTERED | FROM | TO |
|---------------------------------------|-----------|------------|--|------|----|
| Mixed | 0 | 30 |  | | |
| Clay | 30 | 60 | | | |
| Pea gravel | 60 | 105 | | | |
| | | | | | |
| | | | | | |
IF MORE SPACE IS NEEDED, USE BACK

If well telescopes please
sketch and show depths.

GROUND LEVEL

| | | | |
|--|--|---|--|
| | | | |
| | | | |
| | | X | |
| | | | |

SECTION 6

Please indicate well location X.

ADDITIONAL INFORMATION

If more than one screen,
show location of each on sketch.