

MISSISSIPPI DEPARTMENT OF ENVIRONMENTAL QUALITY

Office of Land and Water Resources

P. O. Box 10631
Jackson, MS 39289-0631
WATER WELL DRILLERS LOG

COUNTY WELL LOCATED
Wash.

WELL NUMBER
A143

CODED

DATE WELL COMPLETED
12 Sept 92

PERMIT NUMBER

NAME OF DRILLING FIRM
LAMBSON

NAME & MAILING ADDRESS OF LANDOWNER
Ray Dobbins.

Stringtown Rd.

Greenville, ms.

WELL LOCATION: SEC **2** TOWNSHIP **19 N** RANGE **8 W**

DISTANCE **10** Miles DIRECTION **N** of NEAREST TOWN **Green.**

OTHER LANDMARK

WELL PURPOSE: Home, Irrigation, Municipal, Industrial, Fish Pond, etc.
home

PUMP DATA

PUMP TYPE (Circle One):
Submersible, Turbine, Jet, Flowing Well,
Other (Describe) _____

POWER TYPE (Circle One):
Electric, Tractor, Diesel, Gasoline, Butane,
Other (Describe) _____ H/P **1 1/2**

Pump Capacity (GPM) 27	No. of Stages 11	Setting Depth 105 FT.
----------------------------------	----------------------------	---------------------------------

PUMP TEST

Well yielded _____ GPM with
a drawdown of _____ ft.
after _____ hours of pumping

WELL DATA

Well Depth 540	Casing Diameter (In.) 4x2	Casing Length (Ft.) 520
Type of Casing PVC	Hole Depth 540	Depth to Static Water Level 42'

TYPE OF COMPLETION: (Circle One or More):
Gravel Packed, Underreamed, Telescoped,
Natural Development, Open Hole, Other
(Describe) _____

LOG DATA

TYPE OF LOG RUN (Circle One):
No Log Run, Electric, Gamma Ray, Density, Sonic, Neutron,
Other (Describe) _____

Name of Organization Running Log

WELL GROUTED TO A DEPTH OF _____ FEET
Type Grout (circle one): Cement, Bentonite, or Mix

GEOLOGIC DATA (Office Use Only)

Surface Elev.	Geologic Unit	Unit Thickness	Depth to Top
Subs. SWL	Date	Analysis	Aquifer Test

SCREEN DATA

Diameter - Inches 2"	Length - Feet 20'	Slot Size - Inches .10
Screen Type PVC Rap.	Depth to Bottom - Feet 520-540	


Driller's Remarks

DESCRIPTION OF FORMATIONS ENCOUNTERED	FROM	TO
Mixed	0	5
Clay	5	20
Sand	20	96
Gravel	90	96
Clay	96	170
Clay & Sand	170	470
Sand	470	540

FORMATIONS (Continued)	FROM	TO
RECEIVED		
DEC 10 1992		
Dept. of Environmental Quality Bureau of Land & Water Resources		
IF MORE SPACE IS NEEDED, USE BACK		

If well telescopes please
sketch and show depths.

GROUND LEVEL

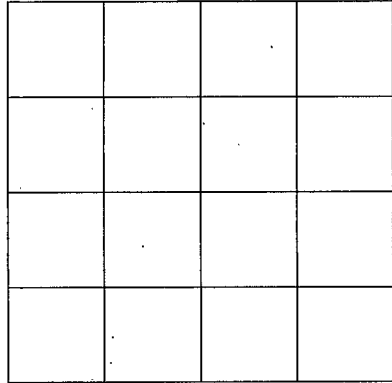

SECTION _____

Please indicate well location X.

ADDITIONAL INFORMATION

If more than one screen,
show location of each on sketch.