

33-31-00 91-04-22

MISSISSIPPI DEPARTMENT OF ENVIRONMENTAL QUALITY

Office of Land and Water Resources

COUNTY WELL LOCATED  
**Washington**

WELL NUMBER <b>A-156</b>	CODED
DATE WELL COMPLETED <b>5-1-01</b>	

PERMIT NUMBER

NAME OF DRILLING FIRM  
**Irrigation Equipment Inc.**

**Indianola, MS**

P. O. Box 10631  
Jackson, MS 39289-0631  
**WATER WELL DRILLERS LOG**

NAME & MAILING ADDRESS OF LANDOWNER  
**Avondale Farms**

**1417 Slab Rd.**  
**Greenville, MS 38703**

Latitude:  
Longitude:

WELL LOCATION. SEC TOWNSHIP RANGE  
**sw/sw 6 19N S 8W E W**

DISTANCE DIRECTION NEAREST TOWN  
**South of Lamont**

OTHER LANDMARK

WELL PURPOSE: Home, Irrigation, Municipal, Industrial, Fish Pond, etc.  
**Irrigation**

**PUMP DATA**

PUMP TYPE (Circle One):  
Submersible, Turbine, Jet, Flowing Well,  
Other (Describe)

POWER TYPE (Circle One):  
Electric, Tractor, Diesel, Gasoline, Butane,  
Other (Describe) **H/P 30**

DESCRIPTION OF FORMATIONS ENCOUNTERED	FROM	TO
Clay	0	29
Fine Sand/gravel	29	35
Med. Sand/gravel	35	103
Clay	103	105

**RECD SEP 10 2001**

**WELL DATA**

Well Depth <b>105</b>	Casing Diameter (In.) <b>16</b>	Casing Length (Ft.) <b>65</b>
Type of Casing <b>pvc</b>	Hole Depth <b>105</b>	Depth to Static Water Level <b>11ft.</b>

TYPE OF COMPLETION: (Circle One or More):  
Gravel Packed, Underreamed, Telescoped,  
Natural Development, Open Hole, Other  
(Describe)

WELL GROUTED TO A DEPTH OF \_\_\_\_\_ FEET  
Type Grout (circle one): Cement, Bentonite, or Mix

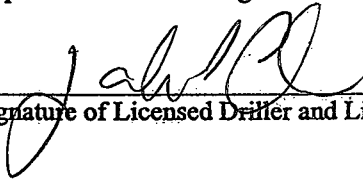
**SCREEN DATA**

Diameter - Inches <b>16</b>	Length - Feet <b>40</b>	Slot Size - Inches <b>.050</b>
Screen Type <b>pvc</b>	Depth to Bottom - Feet <b>105</b>	

Top of Lap Pipe or Reduction in Casing

FEET IF TELESCOPED OR MORE THAN ONE SCREEN: USE BACK PAGE

I certify that the well was drilled, constructed and completed in accordance with all applicable Requirements of the Mississippi Department of Environmental Quality and/or the Mississippi Department of Health regulations and state laws.

 0-439 9-5-01

Signature of Licensed Driller and License No. Date

Additional Information Required On Back

If well telescopes please sketch and show depths.

GROUND LEVEL

X			

SECTION 6

Please indicate well location X.

Pump Capacity (GPM)	No. of Stages	Setting Depth
1500	2	60 FT.

PUMP TEST

Well yielded \_\_\_\_\_ GPM with  
 a drawdown of \_\_\_\_\_ ft.  
 after \_\_\_\_\_ hours of pumping

**LOG DATA**

TYPE OF LOG RUN (Circle One):      No Log Run,  
 Electric, Gamma Ray, Density, Sonic, Neutron,  
 Other (Describe) \_\_\_\_\_

Name of Organization Running Log

**GEOLOGIC DATA (Office Use Only)**

Surface Elev.	Geologic Unit	Unit Thickness	Depth to Top
Subs. SWL	Date	Analysis	Aquifer Test

Driller's Remarks

---



---



If more than one screen,  
 show location of each on sketch.