

COUNTY WELL LOCATED

WASHINGTON

WELL NUMBER  
A-159

CODED

PERMIT NUMBER

GW38870

NAME OF DRILLING FIRM

DATE WELL COMPLETED

7-12-01

Chicot Forigation

Delta Co.

MISSISSIPPI DEPARTMENT OF ENVIRONMENTAL QUALITY

Office of Land and Water Resources

P. O. Box 10631

Jackson, MS 39289-0631

WATER WELL DRILLERS LOG

NAME & MAILING ADDRESS OF LANDOWNER

DELTA CONSERVATION

3038 E. REED RD

GREENVILLE, MS. 38703

WELL LOCATION: SEC TOWNSHIP RANGE  
NW/NW 13 14 19 N 8 E W

DISTANCE DIRECTION NEAREST TOWN  
5.7 Miles North of Greenville

OTHER LANDMARK  
West Side of City Airport

WELL PURPOSE: Home, Irrigation, Municipal, Industrial, Fish Pond, etc.

PUMP DATA

PUMP TYPE (Circle One):  
Submersible, Turbine, Jet, Flowing Well,  
Other (Describe)

POWER TYPE (Circle One):  
Electric, Tractor, Diesel, Gasoline, Butane,  
Other (Describe) H/P 40

Pump Capacity (GPM) No. of Stages Setting Depth  
1500 2 60 FT.

PUMP TEST  
Well yielded \_\_\_\_\_ GPM with  
a drawdown of \_\_\_\_\_ ft.  
after \_\_\_\_\_ hours of pumping

WELL DATA

Well Depth Casing Diameter (In.) Casing Length (Ft.)  
95 12 65

Type of Casing Hole Depth Depth to Static Water Level  
Pvc 98

TYPE OF COMPLETION: (Circle One or More):  
Gravel Packed, Underreamed, Telescoped,  
Natural Development, Open Hole, Other  
(Describe)

WELL GROUTED TO A DEPTH OF \_\_\_\_\_ FEET  
Type Grout (circle one): Cement, Bentonite, or Mix

LOG DATA

TYPE OF LOG RUN (Circle One):  
Electric, Gamma Ray, Density, Sonic, Neutron,  
Other (Describe) No Log Run

Name of Organization Running Log

GEOLOGIC DATA (Office Use Only)

Surface Elev.	Geologic Unit	Unit Thickness	Depth to Top
Subs. SWL	Date	Analysis	Aquifer Test

Driller's Remarks  
33 29 94 56"

090 59 16 10"

Top of Lap Pipe or Reduction in Casing  
FEET IF TELESCOPED OR MORE THAN ONE SCREEN: USE BACK PAGE

SCREEN DATA

Diameter - Inches Length - Feet Slot Size - Inches  
12 30 051

Screen Type Depth to Bottom - Feet  
Pvc 95


DESCRIPTION OF FORMATIONS ENCOUNTERED	FROM	TO
TOP Soil	0	10
Red Clay	10	40
Fine Sand	40	65
Med. Coarse Sand	65	85
Gray Clay	85	98

FORMATIONS (Continued)	FROM	TO

REC'D SEP 07 2001

If well telescopes please  
sketch and show depths.

GROUND LEVEL

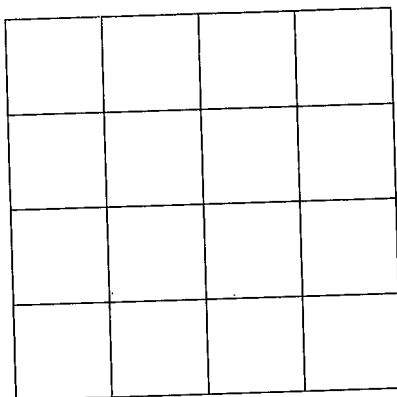

SECTION \_\_\_\_\_

Please indicate well location X.

ADDITIONAL INFORMATION

Lined area for additional information.

If more than one screen,  
show location of each on sketch.