

MISSISSIPPI DEPARTMENT OF ENVIRONMENTAL QUALITY

Office of Land and Water Resources

P. O. Box 10631  
Jackson, MS 39289-0631  
WATER WELL DRILLERS LOG

COUNTY WELL LOCATED  
**WASHINGTON**

WELL NUMBER CODED  
**A-108**

DATE WELL COMPLETED  
**7/31/03**

PERMIT NUMBER  
**MSGW-39406**

NAME OF DRILLING FIRM  
**Stanley Cook Drilling**

NAME & MAILING ADDRESS OF LANDOWNER  
**Bill Hester**  
**225 WARREN RD. EAST**  
**GREENVILLE, MS 38703**

Latitude: **N 33° 29.244'**  
Longitude: **W 091° 2.997'**

WELL LOCATION: SEC **15** TOWNSHIP **19** RANGE **8**  
**NENW** **S** **E**

DISTANCE DIRECTION NEAREST TOWN  
**3** Miles **E** of **WINTERVILLE**

OTHER LANDMARK

WELL PURPOSE: Home, Irrigation, Municipal, Industrial, Fish Pond, etc.

PUMP DATA

PUMP TYPE (Circle One):  
Submersible, Turbine, Jet, Flowing Well,  
Other (Describe)

POWER TYPE (Circle One):  
Electric, Tractor, Diesel, Gasoline, Butane,  
Other (Describe) H/P **60**

DESCRIPTION OF FORMATIONS ENCOUNTERED	FROM	TO
SAND	0	5
CLAY	5	50
SAND	50	60
COURSE SAND	60	70
SAND & GRAVEL	70	108

WELL DATA

Well Depth <b>108</b>	Casing Diameter (In.) <b>16</b>	Casing Length (Ft.) <b>80</b>
Type of Casing <b>PVC</b>	Hole Depth <b>108</b>	Depth to Static Water Level <b>8'</b>

TYPE OF COMPLETION: (Circle One or More):  
Gravel Packed, Underreamed, Telescoped,  
Natural Development, Open Hole, Other  
(Describe)

WELL GROUTED TO A DEPTH OF **5** FEET  
Type Grout (circle one): Cement, Bentonite, or Mix

SCREEN DATA

Diameter - Inches <b>16</b>	Length - Feet <b>28</b>	Slot Size - Inches <b>.050</b>
Screen Type <b>PVC</b>	Depth to Bottom - Feet <b>108</b>	

RECEIVED

AUG 07 2003

BY: OLWR

Top of Lap Pipe or Reduction in Casing  
FEET  IF TELESCOPED OR MORE THAN ONE SCREEN: USE BACK PAGE


I certify that the well was drilled, constructed and completed in accordance with all applicable Requirements of the Mississippi Department of Environmental Quality and/or the Mississippi Department of Health regulations and state laws.

Stanley Cook #0-289  
Signature of Licensed Driller and License No.

8/1/03  
Date

If well telescopes please sketch and show depths.

GROUND LEVEL

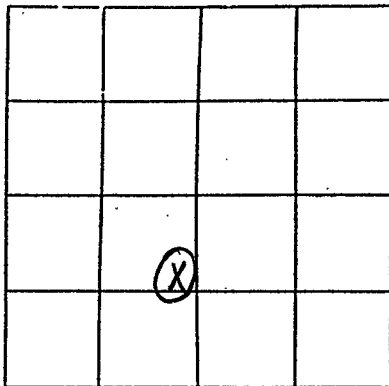

SECTION 17

Please indicate well location X.

Pump Capacity (GPM)	No. of Stages	Setting Depth	FT.
---------------------	---------------	---------------	-----

PUMP TEST

Well yielded \_\_\_\_\_ GPM with  
 a drawdown of \_\_\_\_\_ ft.  
 after \_\_\_\_\_ hours of pumping

LOG DATA

TYPE OF LOG RUN (Circle One):      No Log Run,  
 Electric, Gamma Ray, Density, Sonic, Neutron,  
 Other (Describe) \_\_\_\_\_

Name of Organization Running Log

GEOLOGIC DATA (Office Use Only)

Surface Elev.	Geologic Unit	Unit Thickness	Depth to Top
Subs. SWL	Date	Analysis	Aquifer Test

Driller's Remarks

---



---



If more than one screen,  
 show location of each on sketch.