

# State Well Report

## Part 1

Mississippi Department of Environmental Quality  
Office of Land and Water Resources  
P.O. Box 10631  
Jackson, MS 39289-0631  
(601)961-5210  
(601)354-6938 (fax)

County: WASHINGTON  
Permit # GW 40173  
Driller: SIDNEY COOK  
Date drilling completed: 5/10/05

For Office Use Only:  
Aquifer: \_\_\_\_\_  
Well #: A-180  
L.S. Elevation: \_\_\_\_\_  
E-Log #: \_\_\_\_\_

State Law requires that this report be prepared by the driller in detail and filed with the Department within 30 days of completion of drilling of the well.

Well Owner Information	Well Location
Owner Name <u>DAVID SKELTON</u>	Latitude: <u>N 33° 30.329'</u> Longitude: <u>W 91° 1.797'</u>
Mailing Address: <u>P O BOX 217</u>	Method of Lat/Long (circle one): <u>Conventional Survey</u> , USGS quad, <u>Hand-held GPS</u> , Survey-grade GPS
<u>WINTERVILLE</u> <u>MS</u> <u>38782</u> City State Zip Code	<u>NW 1/4 SE 1/4</u> Sec <u>9</u> Twn <u>19N</u> Rng <u>8W</u>
Telephone No. ( ) _____	Distance Direction Nearest Town <u>2</u> Miles <u>E</u> of <u>WINTERVILLE</u>

**Well Data**

Purpose of Well (circle one) Home Industrial Public Supply Irrigation Fish Culture Other \_\_\_\_\_

Date well drilling started: 5/10/05 Date well drilling completed: 5/10/05

If flowing, method of flow regulation: Valve \_\_\_\_\_ Other (describe) \_\_\_\_\_

Static Water Level: 28 feet above of below (circle one) land surface Date measured: 5/10/05

Method of Measurement (circle one) steel tape electric tape air line other: \_\_\_\_\_

Hole depth: 113 Well depth: 113 Well grouted to a depth of 10 feet

Type of grout (circle one): Cement Bentonite Mix

Casing Length: 73 feet Casing diameter: 16 inches Type of casing: PVC

Screen Length: 40 feet Screen diameter: 16 inches Type of screen: PVC

Screen slot size: .050 inches Setting depth: From 0 feet to 113 feet

Type of completion (circle all applicable): Gravel packed Underreamed Telescoped Open hole Natural Development  
Other (describe): \_\_\_\_\_


Top of lap pipe or reduction in casing: \_\_\_\_\_ feet If telescoped or more than one screen, describe on back of page

Logs run (circle all applicable): No log run Electric Gamma Ray Density Sonic Neutron Other: \_\_\_\_\_

Name of organization running log(s): \_\_\_\_\_

I certify that the well drilled, constructed, and completed in accordance with all applicable requirements of the Mississippi Department of Environmental Quality and/or the Mississippi Department of Health regulations and state laws.

Sidney Cook #0-289  
Print Name of Water Well Contractor and License No.

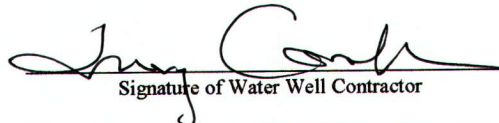  
Signature of Water Well Contractor

RECEIVED  
MAY 24 2005  
BY: OLWR

If well telescopes please sketch below and show depths.

A-180


Ground Level

Description of Formations Encountered	From	To
Topsoil	0	15
Clay	15	73
Heavy Sand and Gravel	73	113

GW 40173

If more than one screen, show location of each on sketch

Sketch the property layout and include the following: 1) the well location; 2) any permanent structures on the property that may aid in locating the well; 3) any roads, power lines, or other items that may aid in locating the property and the well; 4) indicate direction.

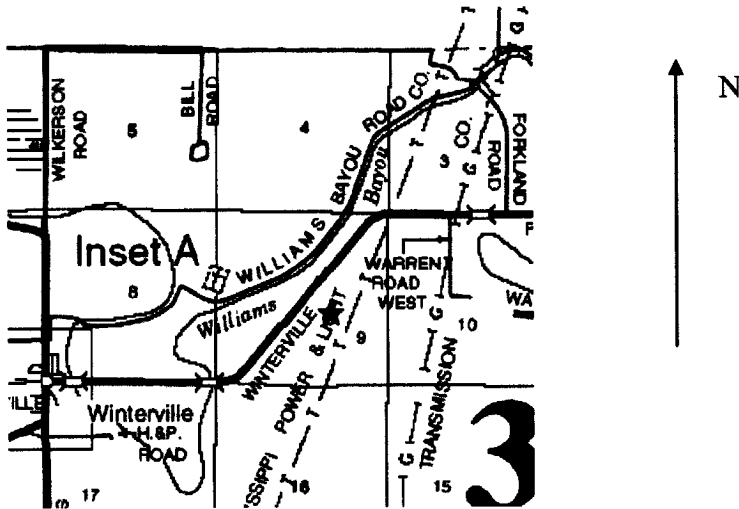

Landowner Name: David Skelton

*Signature of Water Well Contractor*  
Signature of Water Well Contractor

RECEIVED  
MAY 24 2005  
BY: OLWR

# STATE WELL REPORT

## Part 2

**Pump Installer's Completion Report**  
Mississippi Department of Environmental Quality  
Office of Land and Water Resources  
P.O. Box 10631  
Jackson, MS 39289-0631  
(601)961-5210  
(601)354-6938 (fax)

County: WASHINGTON  
Permit #: GW 40173  
Driller: SIDNEY COOK  
Date completed: 5/14/05

For Office Use Only:  
Aqiter: \_\_\_\_\_  
Well #: A-180  
Elevation: \_\_\_\_\_

This report should be prepared by the pump installer in detail and filed with Department within 30 days of the installation of pump.

Well Owner Information	Well Location
Owner Name <u>DAVID SKELTON</u>	Latitude: <u>N 33° 30.329'</u> Longitude: <u>W 91° 1.797'</u>
Mailing Address: <u>P.O. BOX 217</u>	Method of Lat/Long (circle one): Conventional Survey, USGS quad, <u>Hand-held GPS</u> , Survey-grade GPS
<u>WINTERVILLE</u> MS <u>38782</u>	<u>NW</u> ¼ <u>SE</u> ¼ Sec <u>9</u> Twn <u>19N</u> Rng <u>8W</u>
City State Zip Code	Distance Direction Nearest Town
Telephone No. ( ) _____	<u>2</u> Miles <u>E</u> of <u>WINTERVILLE</u>

Pump Type Circle one	Power Type Circle one
Air Lift Jet Submersible	<u>Diesel Engine</u> Gasoline Engine Natural Gas
Bucket Piston <u>Turbine</u>	Electric Motor Hand Tractor PTO
Centrifugal Rotary Flowing Well	Windmill Other (specify): _____
Other (specify): _____	Horse Power Rating of Motor: <u>60</u> HP
Date Pump Installed: <u>5/14/05</u>	Setting Depth: <u>70</u> feet
Rated Pump Capacity: <u>2800</u> Gallons Per Minute	Number of Stages: <u>1</u>

Pump Test Data	Method of Measuring Water Level Circle one
Date Well Tested: _____	Air Line Electric Measuring Line <u>Steel Tape</u>
Static Water Level (A): <u>26</u> Feet Below Land Surface	Other (specify): _____
Pumping Water Level (B): _____ Feet Below Land Surface	For flowing well, measured shut in head: _____ feet
Drawdown [(B)-(A)]: _____ Feet Below Land Surface	Well yielded _____ GPM with a drawdown of _____ feet after _____ hours of pumping
Test Pumping Rate: _____ Gallons Per Minute	
Duration of Pump Test (minimum 4 hours): _____ hours	

I HEREBY CERTIFY that the above statements are true to the best of my knowledge.

Matt Stephens #0-743P  
Print Name of Pump Installer and License No. (if applicable)

Matt Stephens  
Signature of Pump Installer

RECEIVED  
MAY 24 2005  
BY: OLWR