

State Well Report

Part 1

Mississippi Department of Environmental Quality
Office of Land and Water Resources
P.O. Box 10631
Jackson, MS 39289-0631
(601)961-5210
(601)354-6938 (fax)

For Office Use Only:

Aquifer: _____
Well #: A219
L. S. Elevation: _____
E-log #: _____

County: WASHINGTON
Permit #: GW43398
Driller: J. NEWCOME 0-773
Date drilling completed: 6-13-09

State Law requires that this report be prepared by the driller in detail and filed with the Department within 30 days of completion of drilling of the well.

| Well Owner Information | Well Location |
|--|--|
| Owner Name: <u>Hilliard Plantation</u> | Latitude: <u>33.31.35"</u> Longitude: <u>91.05.16"</u> |
| Mailing Address: <u>85 Melon Rd</u> | Method of Lat/Long (circle one): <u>Conventional Survey</u> |
| <u>Greenville MS 38703</u> | USGS quad, <u>Hand-held GPS</u> Survey-grade GPS |
| City State Zip Code | <u>SE 1/4 NW 1/4</u> Sec <u>27</u> Twn <u>19N</u> Rng <u>9W</u> |
| Telephone No. () _____ | Distance <u>7.5</u> Miles Direction <u>North</u> of Nearest Town <u>GREENVILLE</u> |

Well Data

Purpose of Well (circle one) Home Industrial Public Supply Irrigation Fish Culture Other: _____

Date well drilling started: 6-13-09 Date well drilling completed: 6-13-09

If flowing, method of flow regulation: Valve _____ Other (describe) _____

Static Water Level: _____ feet above or below (circle one) land surface Date measured: _____

Method of Measurement (circle one) steel tape electric tape air line other: _____

Hole depth: 103 Well depth: 100 Well grouted to a depth of 10 feet

Type of grout (circle one): Cement Bentonite Mix

Casing length: 60 feet Casing diameter: 14 inches Type of casing: PVC

Screen length: 40 feet Screen diameter: 14 inches Type of screen: PVC

Screen slot size: .050 inches Setting depth: From 60 feet to 100 feet

Type of completion (circle all applicable): Gravel packed Underreamed Telescoped Open hole Natural Development

Other (describe): _____

Top of lap pipe or reduction in casing: _____ feet. If telescoped or more than one screen, describe on back of page

Logs run (circle all applicable) No log run Electric Gamma Ray Density Sonic Neutron Other: _____

Name of organization running log(s): _____

I certify that the well was drilled, constructed, and completed in accordance with all applicable requirements of the Mississippi Department of Environmental Quality and/or the Mississippi Department of Health regulations and state laws.

JOHN NEWCOME 0-773

Print Name of Water Well Contractor and License No.

[Signature]
Signature of Water Well Contractor

RECEIVED


JUL 30 2009

BY: OLWR

A 219

If well telescopes please sketch below and show depths.

Ground Level

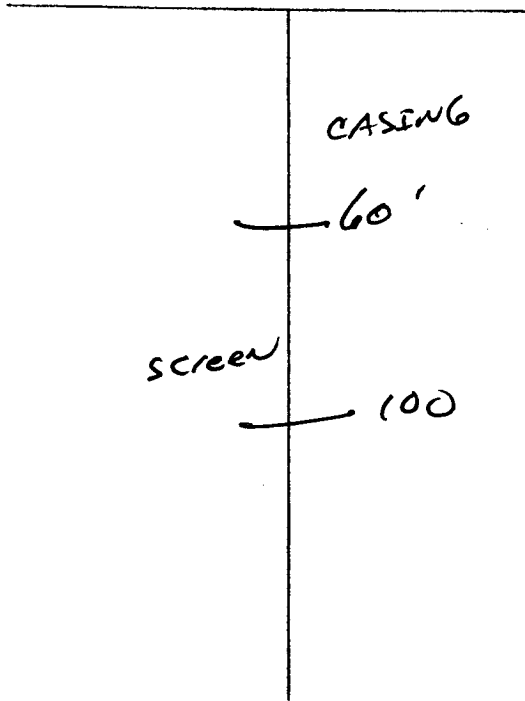


Description of Formations Encountered

| Description of Formations Encountered | From | To |
|---------------------------------------|------|-----|
| TOP Soil | 0 | 10 |
| Mix CLAY | 10 | 38 |
| Fine sand | 38 | 60 |
| Med. COARSE sand | 60 | 95 |
| COARSE Sand | 95 | 100 |
| Gray CLAY | 100 | 103 |
| | | |
| | | |
If more than one screen, show location of each on sketch

Sketch the property layout and include the following: 1) the well location; 2) any permanent structures on the property that may aid in locating the well; 3) any roads, power lines, or other items that may aid in locating the property and the well; 4) indicate direction.

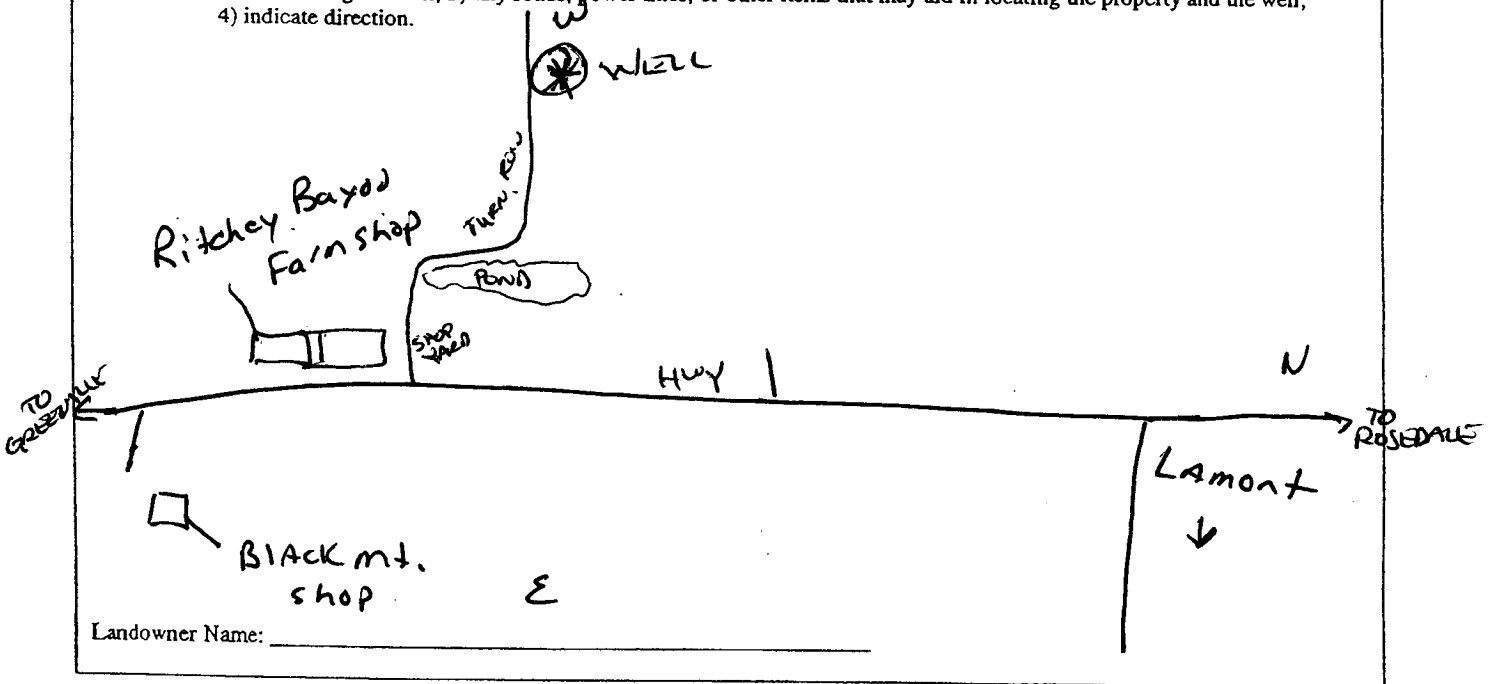

[Signature]
 Signature of Water Well Contractor

STATE WELL REPORT

Part 2

Pump Installer's Completion Report
 Mississippi Department of Environmental Quality
 Office of Land and Water Resources
 P.O. Box 10631
 Jackson, MS 39289-0631
 (601)961-5210
 (601)354-6938 (fax)

For Office Use Only:

Aquifer: _____
 Well #: A 219
 Elevation: _____

County: Washington
 Permit #: _____
 Driller: J. Newcome
 Date completed: 6/13/09

This report should be prepared by the pump installer in detail and filed with the Department within 30 days of the installation of pump.

| Well Owner Information | Well Location |
|--|--|
| Owner Name: <u>Hilliard Plantation</u> | Latitude: <u>33° 31' 35"</u> Longitude: <u>91° 05' 16"</u> |
| Mailing Address: <u>85 Melon Rd</u> | Method of Lat/Long (circle one): Conventional Survey |
| <u>Greenville MS 38703</u> | USGS quad <u>SW</u> <u>Hand-held GPS</u> Survey-grade GPS |
| City State Zip Code | <u>SW</u> $\frac{1}{4}$ <u>NW</u> $\frac{1}{4}$ Sec <u>27</u> Twn <u>19N</u> Rng <u>9W</u> |
| Telephone No. () _____ | Distance Direction Nearest Town |
| | <u>7.5</u> Miles <u>N</u> of <u>Greenville</u> |

| Pump Type Circle one | Power Type Circle one |
|---|--|
| Air Lift Jet Submersible | <u>Diesel Engine</u> Gasoline Engine Natural Gas |
| Bucket Piston <u>Turbine</u> | Electric Motor Hand Tractor PTO |
| Centrifugal Rotary Flowing Well | Windmill Other (specify): _____ |
| Other (specify): _____ | Horse Power Rating of Motor: <u>60</u> |
| Date Pump Installed: <u>6/14/09</u> | Setting Depth: <u>70</u> feet |
| Rated Pump Capacity: <u>2600</u> Gallons Per Minute | Number of Stages: <u>1</u> |

| Pump Test Data | Method of Measuring Water Level Circle one |
|---|---|
| Date Well Tested: _____ | Air Line Electric Measuring Line Steel Tape |
| Static Water Level (A): _____ Feet Below Land Surface | Other (specify): _____ |
| Pumping Water Level (B): _____ Feet Below Land Surface | For flowing well, measured shut in head: _____ feet |
| Drawdown [(A) - (B)]: <u>Not Tested</u> Feet Below Land Surface | Well yielded _____ GPM with a drawdown of _____ feet after _____ hours of pumping |
| Test Pumping Rate: _____ Gallons Per Minute | |
| Duration of Pump Test (minimum 4 hours): _____ hours | |

I HEREBY CERTIFY that the above statements are true to the best of my knowledge.

Comp Rowe 0-711P [Signature]
 Print Name of Pump Installer and License No. (if applicable) Signature of Pump Installer

RECEIVED
 JUL 30 2009
 BY: OLWR