

Elizabeth Shannon

# State Well Report

## Part 1

Mississippi Department of Environmental Quality  
Office of Land and Water Resources  
P.O. Box 10631  
Jackson, MS 39289-0631  
(601)961-5210  
(601)354-6938 (fax)

For Office Use Only:

Aquifer: A 226  
Well #: \_\_\_\_\_  
L. S. Elevation: \_\_\_\_\_  
E-log #: \_\_\_\_\_

County: WASHINGTON  
Permit #: 6W44475  
Driller: J. Newcome 0-775  
Date drilling completed: 8-2-10

State Law requires that this report be prepared by the driller in detail and filed with the Department within 30 days of completion of drilling of the well.

Well Owner Information	Well Location
Owner Name: <u>Elizabeth Shannon</u>	Latitude: <u>33° 28' 14"</u> Longitude: <u>90° 59' 46"</u>
Mailing Address: <u>516 Metcalf Rd</u>	Method of Lat/Long (circle one): Conventional Survey, <u>04</u> <u>41</u>
<u>Greenville, MS 38703</u>	USGS quad: <u>Hand-held GPS</u> Survey-grade GPS <input checked="" type="checkbox"/>
City State Zip Code	<u>NW</u> 1/4 <u>NE</u> 1/4 Sec <u>26</u> Twn <u>19</u> Rng <u>8W</u>
Telephone No. ( ) _____	Distance Direction Nearest Town <u>5</u> Miles <u>NE</u> of <u>GREENVILLE</u>

**Well Data**

Purpose of Well (circle one) Home Industrial Public Supply Irrigation Fish Culture Other: \_\_\_\_\_

Date well drilling started: 8-2-10 Date well drilling completed: 8-2-10

If flowing, method of flow regulation: Valve \_\_\_\_\_ Other (describe) \_\_\_\_\_

Static Water Level: \_\_\_\_\_ feet above or below (circle one) land surface Date measured: \_\_\_\_\_

Method of Measurement (circle one) steel tape electric tape air line other: \_\_\_\_\_

Hole depth: 102 Well depth: 100 Well grouted to a depth of 10 feet

Type of grout (circle one): Cement Bentonite Mix

Casing length: 60 feet Casing diameter: 16 inches Type of casing: PVC

Screen length: 40 feet Screen diameter: 16 inches Type of screen: PVC

Screen slot size: 050 inches Setting depth: From 50-70 feet to 80-100 feet

Type of completion (circle all applicable): Gravel packed Underreamed Telescoped Open hole Natural Development

Other (describe): \_\_\_\_\_

Top of lap pipe or reduction in casing: \_\_\_\_\_ feet. If telescoped or more than one screen, describe on back of page

Logs run (circle all applicable): No log run Electric Gamma Ray Density Sonic Neutron Other: \_\_\_\_\_

Name of organization running log(s): \_\_\_\_\_

I certify that the well was drilled, constructed, and completed in accordance with all applicable requirements of the Mississippi Department of Environmental Quality and/or the Mississippi Department of Health regulations and state laws.


JOHN NEWCOME 0-775  
Print Name of Water Well Contractor and License No.

[Signature]  
Signature of Water Well Contractor

RECEIVED  
AUG 19 2010  
BY: OLWR


If well telescopes please sketch below and show depths.

Ground Level

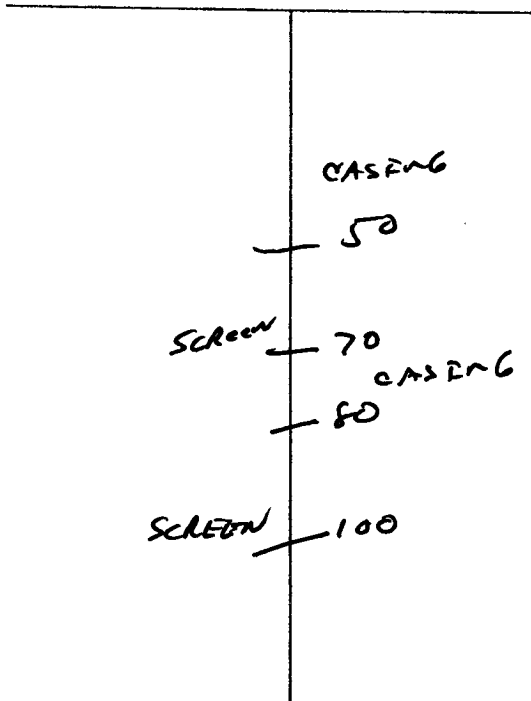


Description of Formations Encountered	From	To
TOP Soil	0	10
FINE sand	10	50
COARSE Sand	50	70
FINE Sand	70	80
COARSE Sand	80	100
Sandstone	100	102

If more than one screen, show location of each on sketch

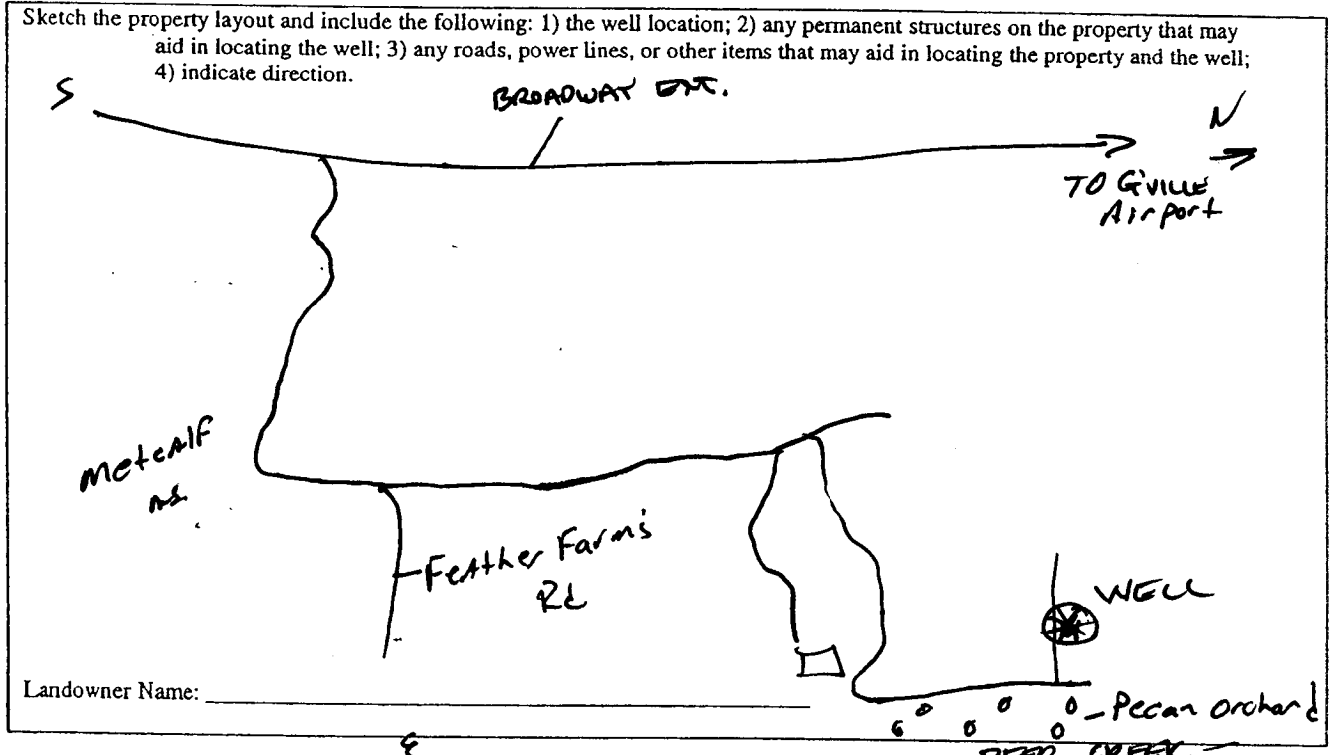

Landowner Name: \_\_\_\_\_

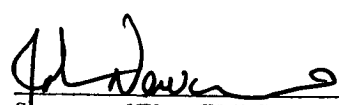  
 \_\_\_\_\_  
 Signature of Water Well Contractor

# STATE WELL REPORT

## Part 2

**Pump Installer's Completion Report**  
 Mississippi Department of Environmental Quality  
 Office of Land and Water Resources  
 P.O. Box 10631  
 Jackson, MS 39289-0631  
 (601)961-5210  
 (601)354-6938 (fax)

County: Washington  
 Permit #: EW 44175  
 Driller: J. Newcome  
 Date completed: 8/2/10

For Office Use Only:

Aquifer: A 2 26  
 Well #: \_\_\_\_\_  
 Elevation: \_\_\_\_\_

This report should be prepared by the pump installer in detail and filed with the Department within 30 days of the installation of pump.

Well Owner Information	Well Location
Owner Name: <u>Elizabeth Shannon</u>	Latitude: <u>35° 28.14</u> Longitude: <u>90° 59.46</u>
Mailing Address: <u>516 Metcalfe Rd</u>	Method of Lat/Long (circle one): Conventional Survey,
<u>Greenville, MS 38703</u>	USGS quad: <u>Hand-held GPS</u> Survey-grade GPS
City State Zip Code	<u>NW 1/4 NE 1/4 Sec 20 Twn 19 Rng 8W</u>
Telephone No. ( ) _____	Distance Direction Nearest Town
	<u>5</u> Miles <u>NE</u> of <u>Greenville</u>

Pump Type Circle one	Power Type Circle one
Air Lift Jet Submersible	<u>Diesel Engine</u> Gasoline Engine Natural Gas
Bucket Piston <u>Turbine</u>	Electric Motor Hand Tractor PTO
Centrifugal Rotary Flowing Well	Windmill Other (specify): _____
Other (specify): _____	Horse Power Rating of Motor: <u>60</u>
Date Pump Installed: <u>8/2/10</u>	Setting Depth: <u>70</u> feet
Rated Pump Capacity: _____ Gallons Per Minute	Number of Stages: <u>2</u>

Pump Test Data	Method of Measuring Water Level Circle one
Date Well Tested: _____	Air Line Electric Measuring Line Steel Tape
Static Water Level (A): _____ Feet Below Land Surface	Other (specify): _____
Pumping Water Level (B): _____ Feet Below Land Surface	For flowing well, measured shut in head: _____ feet
Drawdown [(B) - (A)]: _____ Feet Below Land Surface	Well yielded _____ GPM with a drawdown of _____ feet after _____ hours of pumping
Test Pumping Rate: _____ Gallons Per Minute	
Duration of Pump Test (minimum 4 hours): _____ hours	

I HEREBY CERTIFY that the above statements are true to the best of my knowledge.

Cony Rowe 0-711P  
 Print Name of Pump Installer and License No. (if applicable)

[Signature]  
 Signature of Pump Installer

RECEIVED

AUG 19 2010

BY: OLWR