
	Pantha	r Burn Pit.	
<u> </u>		ell Report	
County: WASHINGTON	Pa	urt 1	For Office Use Only:
Permit #: MS-GN-44605	Mississippi Department of Environmental Quality		Aquifer: A 230
Driller: J. NEWCOME 0-773	Office of Land and Water Resources P.O. Box 10631		Well #:
	Jackson, MS 39289-0631		L. S. Elevation:
Date drilling completed: 11-22-10	(601)961-5210 (601)354-6938 (fax)		E-log #:
State Law requires that this rep		driller in detail and filed w	with the Department within
<u>30 days of completion of drilling</u> Well Owner Inform		Wel	l Location
Owner Name Panher	Burn Pit.	Latitude: 33 . 04 . 19	" Longitude: 90 . 49 . 41.
Mailing Address: 1427 5.M	Address: 1427 S. Main St Method of Lat/Lon		ne): Conventional Survey,
Suite 15	SUITE 153 USGS quad, Hand-he		I GPS) Survey-grade GPS
Greenville	MS 38701	SW 14 SW 14 Sec 09	Twn HA Rng 5W
	tate Zip Code	Distance Direction	Nearest Town
Telephone No. ()		2 Miles SE	of PANTED BURN
	Well J	Data	
Purpose of Well (circle one) Home Ir	ndustrial Public Supply	Irrigation Fish Culture	Other:
Date well drilling started: 11-22			22-10
If flowing, method of flow regulation: V	alve Other (o	lescribe)	
Static Water Level:feet	above or below (circle one)	land surface Date measured	• •
Method of Measurement (circle one)	steel tape electric tape	air line other:	
Hole depth: 113 Well of	depth: 110	_ Well grouted to a depth of	feet
Type of grout (circle one): Cement	Bentonite Mix		0
Casing length: 70 feet Ca	asing diameter: 16		
Screen length: <u>40</u> feet So	creen diameter: <u>16</u>	inches Type of screen:	Prc
Screen slot size:OSOinche	s Setting depth: From	70 feet to	110feet
Type of completion (circle all applicable	e): Gravel packed Unde	erreamed Telescoped Op	en hole Natural Development
	Other (describe):	· · · · · · · · · · · · · · · · · · ·	
Top of lap pipe or reduction in casing:	feet. If	telescoped or more than one s	creen, describe on back of page
Logs run (circle all applicable): No log	Electric Gamma Ra	y Density Sonic Neutron	Other:
Name of organization running log(s):			
I certify that the well was drilled, con	structed, and completed in	accordance with all applicab	le requirements of the Mississipp
Department of Environmental Qualit	y and/or the Mississippi De	epartment of Health regulatio	ns and state laws.
AS		$\lambda \lambda = \lambda$	
So JOHN NEWKON			liven o
Prant Name of Water Well Contractor a	and License No.	Signature	of Water Well Contractor
			RECEI
			050 0 9
			DEC 2 3
			BY: OL
			BY:

If well telescopes please sketch below and show depths.

Ground Level

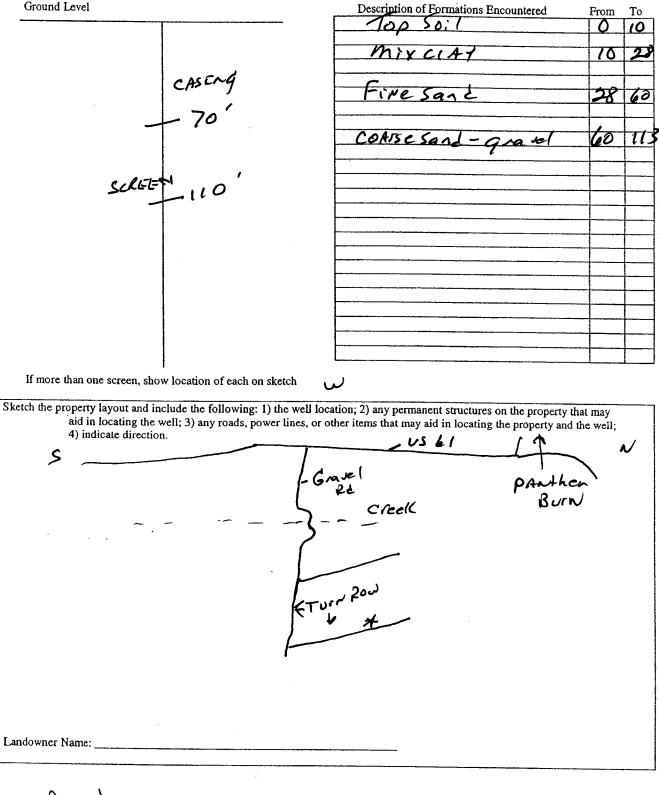

Ĵ,

nature of Water Well Contractor

STATE WELL REPORT				
County: Washingth Permit #: MS - GW 44605 Driller: <u>J. Newcowe 0-773</u> Date completed: <u>11/2210</u> Pump Installer's Mississippi Departmen Office of Land a P.O. H Jackson, M (601) (601)35	art 2 For Office Use Only: c Completion Report Aquifer: t of Environmental Quality Aquifer: Max and Water Resources Well #: Sox 10631 Well #: 961-5210 Elevation:			
This report should be prepared by the pump installer in detail and filed with the Department within 30 days of the installation of pump.				
Well Owner Information Owner Name: PomMer Burn PIT.	Well Location Latitude: <u>30418</u> Longitude: <u>90494</u> 1 Method of Lat/Long (circle one): Conventional Survey, USGS quad, Hand-heid GPS) Survey-grade GPS <u>SW 145W 14 Sec 09 Twn 14N Rng SW</u>			
Mailing Address: 1427 S. Main St Swife 153				
City State Zip Code				
Telephone No. ()	Distance Direction Nearest Town <u>2 Miles SE of PantWelp Burn</u>			
Pump Type Circle one	Power Type Circle one			
Air Lift Jet Submersible	Diesel Engine Gasoline Engine Natural Gas			
Bucket Piston Turbine	Electric Motor Hand Tractor PTO			
Centrifugal Rotary Flowing Well	Windmill Other (specify):			
Other (specify): Date Pump Installed: Rated Pump Capacity: Gallons Per Minute	Horse Power Rating of Motor:			
Pump Test Data	Method of Measuring Water Level Circle one			
Date Well Tested:Feet Below Land Surface Pumping Water Level (B):Feet Below Land Surface	Air Line Electric Measuring Line Steel Tape Other (specify):			
Drawdown [(B) - (A)]:Feet Below Land Surface	For flowing well, measured shut in head:feet			
Test Pumping Rate:Gallons Per Minute -	Well yielded GPM with a drawdown of			
Duration of Pump Test (minimum 4 hours):hours	feet afterhours of pumping			
I HEREBY CERTIFY that the above statements are true to the best <u>Cov</u> <u>Rowe</u> <u>O-711</u> P Print Name of Pump Installer and License No. (if applicable)	of my knowledge. Signature of Pump Installer			
· · ·	RECEIVED			
	DEC 2 3 2010			

***** '

•

۰.

BY: OLWR