

WASHINGTON

A - 1001

6-27-78

MISSISSIPPI BOARD OF WATER COMMISSIONERS
416 North State Street
Jackson, Mississippi 39201

WATER WELL DRILLERS LOG

June 27 1978 Schultz Peilling Co Washington
date well completed firm name county well located


LANDOWNER:	description of formations encountered	from	to
CORREO Construction Co Hwy 1 South Greenville MS (mailing address) 38701			
WELL LOCATION: sec 29 T 19 N R 8 E 7 miles N of Greenville (distance) (direction) (nearest town)			
WELL PURPOSE: Home (home, irrigation, municipal, industrial)			
WELL COMPLETION DATA:			
(1) diameter (inches) 2"			
(2) total depth (feet) 460			
(3) static water level (feet) 22 below top of ground			
(4) casing PUC 450 (material) (depth) 2" (size) if telescope see back.			
(5) screen 10' 450 (length) (depth to top) 2" (size) PUC (material)			
(6) pump 1 (HP) 10 (yield gpm) ele (type power)			
(7) electric log No (yes or no) (organization running log)			
(8) how well bottom plugged b/w			
DRILLERS REMARKS:			

RECEIVED
DEC 27 1978

MISS. BD. OF WATER COMMISSIONERS

If well telescopes please sketch and show depths.

GROUND LEVEL

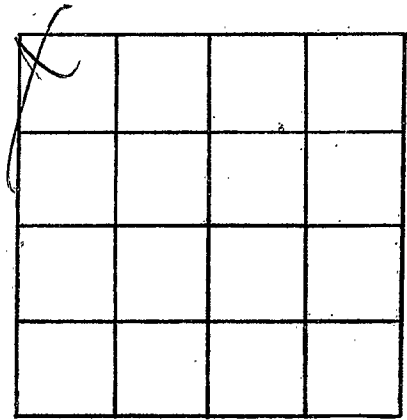

SECTION _____

Please indicate well location X.

ADDITIONAL INFORMATION

If more than one screen, show locations of each on sketch.