

Wash.
A-1002
7-15-79

MISSISSIPPI
 BOARD OF WATER COMMISSIONERS
 416 North State Street
 Jackson, Mississippi 39201

WATER WELL DRILLERS LOG

15 July 1979 Lambert Drilling Co. Wash
 date well completed firm name county well located

LANDOWNER:	description of formations encountered	from	to
<u>Sherman James</u>			
<u>Greenville, Miss.</u> (mailing address)	<u>Mixed</u>	<u>0</u>	<u>15</u>
WELL LOCATION:	<u>Clay</u>	<u>15</u>	<u>43</u>
sec. <u>1</u> T <u>19</u> N R <u>8</u> E S W	<u>Sand</u>	<u>45</u>	<u>85</u>
<u>12</u> miles <u>N</u> of <u>Greenville</u> (distance) (direction) (nearest town)	<u>Sand & gravel</u>	<u>85</u>	<u>205</u>
WELL PURPOSE: <u>None</u> (home, irrigation, municipal, industrial)	<u>Clay</u>	<u>205</u>	<u>290</u>
WELL COMPLETION DATA:	<u>Blend. light</u>	<u>290</u>	<u>405</u>
(1) diameter (inches) <u>2"</u>	<u>Sand med.</u>	<u>405</u>	<u>435</u>
(2) total depth (feet) <u>480</u>	<u>Sand & gravel</u>	<u>435</u>	<u>485</u>
(3) static water level (feet) <u>42</u> below top of ground.			
(4) casing <u>PVC</u> , <u>470</u> , (material) (depth) (size) if telescope see back.			
(5) screen <u>10</u> , <u>480-470</u> (length) (depth to top) <u>2</u> , <u>PVC</u> (size) (material)			
(6) pump <u>1</u> , <u>10</u> (HP) (yield gpm) <u>elect</u> (type power)			
(7) electric log _____ (yes or no) _____ (organization running log)			
(8) how well bottom plugged <u>back press.</u>			
DRILLERS REMARKS:			


DEPT. OF NATURAL RESOURCES
 BUREAU OF LAND & WATER RESOURCES

JAN 9 1980

RECEIVED

If well telescopes please sketch and show depths.

GROUND LEVEL

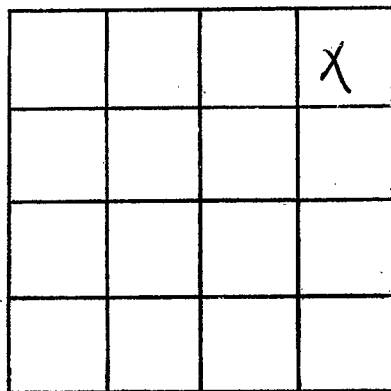

SECTION 1

Please indicate well location X.

ADDITIONAL INFORMATION

If more than one screen,
show locations of each on sketch.