

Wash.
A 1003
8-17-79

MISSISSIPPI
BOARD OF WATER COMMISSIONERS
416 North State Street
Jackson, Mississippi 39201

WATER WELL DRILLERS LOG

17 Aug 1979 Lambert Drilling Co. Wash
date well completed firm name county well located

LANDOWNER:	description of formations encountered	from	to
Dr. Milton York Greenville, Miss. (mailing address)			
WELL LOCATION: sec. 2 T. 19 N. R. 8 E. 5 miles N of Greenville (distance) (direction) (nearest town)	Clay	10	30
WELL PURPOSE: home (home, irrigation, municipal, industrial)	Sand	30	90
WELL COMPLETION DATA: (1) diameter (inches) 4x2 (2) total depth (feet) 495 (3) static water level (feet) 46 below top of ground. (4) casing PVC, 475 (material) (depth) 4x2 (size) If telescope see back. (5) screen 20, 495x475 (length) (depth to top) 2" PVC (size) (material) (6) pump 2, 30 (HP) (yield gpm) elect (type power) (7) electric log (yes or no) (organization running log) (8) how well bottom plugged back press	fine gravel	90	110
	Clay	110	260
	Clay st. Sand	260	330
	Sand st. Clay	330	410
	Sand med	410	450
	sand good	450	495
DRILLERS REMARKS:			

DEPT. OF NATURAL RESOURCES
BUREAU OF LAND & WATER RESOURCES

JAN 9 1980

RECEIVED


If well telescopes please sketch and show depths.

GROUND LEVEL

11" 160

2" 475

scr. 2" 495

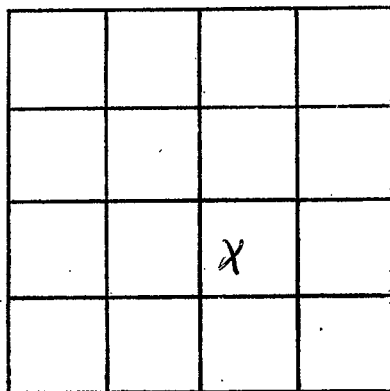

SECTION 2

Please indicate well location X.

ADDITIONAL INFORMATION

If more than one screen, show locations of each on sketch.