

WASHINGTON
 A 1006
 2-28-80

MISSISSIPPI
 BOARD OF WATER COMMISSIONERS
 416 North State Street
 Jackson, Mississippi 39201

WATER WELL DRILLERS LOG

28 Feb 1980 Lambert Drilling Co. Wash
 date well completed firm name county well located

LANDOWNER:	description of formations encountered	from	to
Tommy Lockett Stringtown (mailing address)			
WELL LOCATION:	sand	10	60
sec 1 T 19 N R 8 E 10 SE miles N of Greenville (distance) (direction) (nearest town)	sand & gravel	60	170
WELL PURPOSE: none (home, irrigation, municipal, industrial)	Clay	170	310
WELL COMPLETION DATA:	Sand (Fine)	310	420
(1) diameter (inches) 2	Sand (Med)	420	450
(2) total depth (feet) 480	Sand (Good)	450	480
(3) static water level (feet) 88 below above top of ground.			
(4) casing PVC 470 (material) (depth)			
(size) If telescope see back.			
(5) screen 2" 480-470 (length) (depth to top)			
2" PVC (size) (material)			
(6) pump 1 9 (HP) (yield gpm)			
elect (type power)			
(7) electric log _____ (yes or no)			
(organization running log)			
(8) how well bottom plugged back press.			
DRILLERS REMARKS:			


DEPT. OF NATURAL RESOURCES
 BUREAU OF LAND & WATER RESOURCES

MAY 27 1980

RECEIVED

If well telescopes please sketch and show depths.

GROUND LEVEL

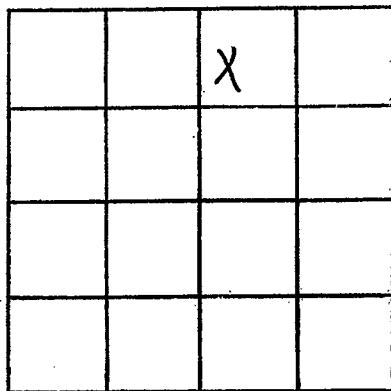

SECTION 1

Please indicate well location X.

ADDITIONAL INFORMATION

If more than one screen,
show locations of each on sketch.