

Washington
 A 1007
 3-4-80

MISSISSIPPI
 BOARD OF WATER COMMISSIONERS
 416 North State Street
 Jackson, Mississippi 39201

WATER WELL DRILLERS LOG

4 mar 1980 Lambert Drilling Wash
 date well completed firm name county well located

| LANDOWNER: | description of formations encountered | from | to |
|---|---------------------------------------|------|-----|
| H. Hammett Greenville, Miss. (mailing address) | | | |
| | Sand | 20 | 76 |
| WELL LOCATION: 10 sec 39 T 17 N R 8 E W 6 miles NE of Greenville (distance) (direction) (nearest town) | Pea gravel | 70 | 106 |
| | Clay | 106 | 205 |
| WELL PURPOSE: Industrial (home, irrigation, municipal, industrial) | Clay & sand | 205 | 295 |
| WELL COMPLETION DATA: | Sand good | 295 | 375 |
| (1) diameter (inches) 4x2 | Sand med. | 375 | 390 |
| (2) total depth (feet) 460 | Sand good | 390 | 460 |
| (3) static water level (feet) 41 below top of ground. | | | |
| (4) casing PVC, 440 (material) (depth) 4x2 (size) if telescope see back. | | | |
| (5) screen 211 (length), 460-440 (depth to top) 211 (size), PVC (material) | | | |
| (6) pump 1 (HP), 20 (yield gpm) elect (type power) | | | |
| (7) electric log (yes or no) | | | |
| (organization running log) | | | |
| (8) how well bottom plugged back pass | | | |
| DRILLERS REMARKS: | | | |

DEPT. OF NATURAL RESOURCES
 BUREAU OF LAND & WATER RESOURCES

MAY 27 1980

RECEIVED


If well telescopes please sketch and show depths.

GROUND LEVEL

140 4''

440 2''

460 2'' scv.

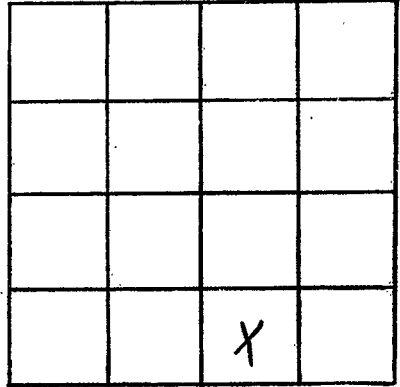

SECTION ¹ 39

Please indicate well location X.

ADDITIONAL INFORMATION

If more than one screen, show locations of each on sketch.