

WASHINGTON

A 1008

5-1-80

MISSISSIPPI BOARD OF WATER COMMISSIONERS
416 North State Street
Jackson, Mississippi 39201

WATER WELL DRILLERS LOG

1 May

date well completed

1980 Lambert Drilling

firm name

Wash

county well located

LANDOWNER:	description of formations encountered	from	to
Roy Thed Ford Greenville, Miss (mailing address)			
WELL LOCATION:			
sec 10 T 19 N R 8 E 9 5/8 miles N of Greenville (distance) (direction) (nearest town)	Sand & gravel Clay	60 120	120 190
WELL PURPOSE:			
home (home, irrigation, municipal, industrial)	Clay st Sand Sand med	190 410	410 440
WELL COMPLETION DATA:			
(1) diameter (inches) 4 X 2	Sand 1st.	440	450
(2) total depth (feet) 510	Sand good	450	570
(3) static water level (feet) 32 below top of ground.			
(4) casing PVC, 490 (material) (depth) 4 X 2 (size) If telescope see back.			
(5) screen 20 (length) 510-490 (depth to top) 2" (size) SS (material)			
(6) pump 1 (HP) 20 (yield gpm) elect (type power)			
(7) electric log (yes or no)			
(organization running log)			
(8) how well bottom plugged back press			
DRILLERS REMARKS:			

DEPT. OF NATURAL RESOURCES
BUREAU OF LAND & WATER RESOURCES

MAY 29 1980

RECEIVED


If well telescopes please sketch and show depths.

GROUND LEVEL

140 4''

490 2''

510 2'' screens

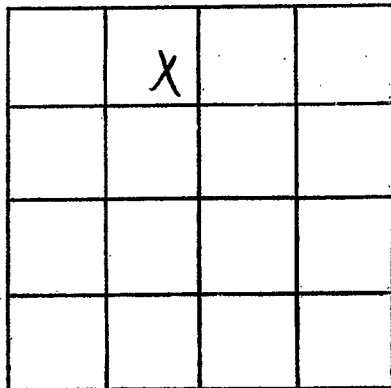

SECTION 10

Please indicate well location X.

ADDITIONAL INFORMATION

If more than one screen, show locations of each on sketch.