

Washington
 A 1009
 9-19-75

MISSISSIPPI
 BOARD OF WATER COMMISSIONERS
 416 North State Street
 Jackson, Mississippi 39201

WATER WELL DRILLERS LOG

19 Sept date well completed 24 Lambert Drilling Co firm name Wash county well located

LANDOWNER:	description of formations encountered	from	to
Dolan Branton			
Greenville, Miss. (mailing address)	m, ved.	0	2
WELL LOCATION: sec 11 T 19 N R 8 E 15 S 10 miles N of Green. (distance) (direction) (nearest town)	Sand.	20	60
WELL PURPOSE: none (home, irrigation, municipal, industrial)	Sand & gravel	60	118
WELL COMPLETION DATA: (1) diameter (inches) 4x2 (2) total depth (feet) 460 (3) static water level (feet) 42 below top of ground. (4) casing PVC, 440 (material) (depth) 4x2 (size) If telescope see back. (5) screen 20' 460-440 (length) (depth to top) 2" PVC (size) (material) (6) pump 1 20 (HP) (yield gpm) Flect. (type power) (7) electric log (yes or no) (organization running log) (8) how well bottom plugged Back Wash	clay	118	180
	Clay st Sand	180	285
	Sand st Clay	285	360
	Sand & Gravel	360	410
	Sand good.	410	480
	Sol. 460		
DRILLERS REMARKS:			

RECEIVED
 MISSISSIPPI
 OCT 26 1975

MISS. BD. OF WATER COMMISSIONERS

If well telescopes please sketch and show depths.

GROUND LEVEL

4"


140

2"

440

20 ft
SC₁

460

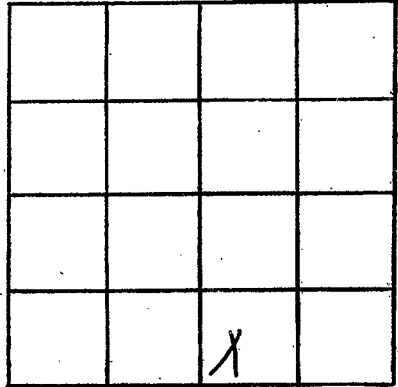

SECTION 11

Please indicate well location X.

ADDITIONAL INFORMATION

If more than one screen, show locations of each on sketch.