

Washington
 A 1010
 5/20/76

MISSISSIPPI
 BOARD OF WATER COMMISSIONERS
 416 North State Street
 Jackson, Mississippi 39201

WATER WELL DRILLERS LOG

May 20 1976 date well completed
 Schultz Drilling firm name
 Washington county well located

LANDOWNER: <u>Home & Livestock</u>	description of formations encountered	from	to
<u>Aracville, Miss</u> (mailing address)			
WELL LOCATION: sec. <u>33</u> T. <u>19</u> N. R. <u>8</u> E <u>3</u> miles <u>N</u> of <u>Cl</u> (distance) (direction) (nearest town)	<u>Clay</u>	<u>0</u>	<u>26</u>
WELL PURPOSE: <u>Home</u> (home, irrigation, municipal, industrial)	<u>sand</u>	<u>26</u>	<u>93</u>
WELL COMPLETION DATA: (1) diameter (inches) <u>2"</u>	<u>Clay</u>	<u>93</u>	<u>147</u>
(2) total depth (feet) <u>560</u>	<u>sand</u>	<u>147</u>	<u>160</u>
(3) static water level (feet) <u>86</u> below top of ground.	<u>Shale</u>	<u>160</u>	<u>290</u>
(4) casing <u>PVC</u> (material) (depth) (size) if telescope see back.	<u>sand</u>	<u>290</u>	<u>310</u>
(5) screen <u>10</u> (length) (depth to top) <u>2</u> <u>PVC</u> (size) (material)	<u>Sandy Shale</u>	<u>310</u>	<u>490</u>
(6) pump <u>1</u> <u>8</u> (HP) (yield gpm) <u>Elc</u> (type, power)	<u>Fine sand</u>	<u>490</u>	<u>510</u>
(7) electric log <u>NO</u> (yes or no)	<u>sand</u>	<u>510</u>	<u>560</u>
(organization running log)			
(8) how well bottom plugged <u>Good</u>			
DRILLERS REMARKS:			


RECEIVED

AUG 24 1976

MISS. BD. OF WATER COMMISSIONERS

If well telescopes please sketch and show depths.

GROUND LEVEL

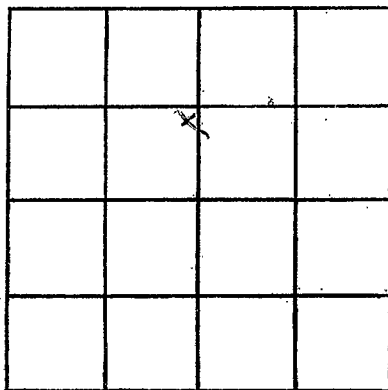

SECTION 33

Please indicate well location X.

ADDITIONAL INFORMATION

If more than one screen,
show locations of each on sketch.