

Washington
A 1012
6-8-76

MISSISSIPPI
BOARD OF WATER COMMISSIONERS
416 North State Street
Jackson, Mississippi 39201

WATER WELL DRILLERS LOG

June 8 1976 date well completed
Schultz Drilling firm name
Washington county well located

LANDOWNER	description of formations encountered	from	to
Charles Turner	Clay	0	29
Greenhill Miss (mailing address)	sand	29	76
WELL LOCATION: sec. 20 T 19 N R 8 E W 4 4 miles N of Owl (distance) (direction) (nearest town)	Gravel	76	102
WELL PURPOSE: Home (home, irrigation, municipal, industrial)	Clay	102	115
WELL COMPLETION DATA: (1) diameter (inches) 2 (2) total depth (feet) 520 (3) static water level (feet) 43 below top of ground. (4) casing PVC (material) (depth) (size) if telescope see back. (5) screen 10 (length) (depth to top) 2 (size) PVC (material) (6) pump 1 (HP) 10 (yield gpm) (type power) (7) electric log NO (yes or no) (8) how well bottom plugged	sand	115	174
	Clay	174	190
	sand & Gravel	190	205
	Clay	205	267
	Sand & Shell	267	390
	sand F. No	390	478
	Shell	478	478
	Sand	478	520
DRILLERS REMARKS:			


RECEIVED

AUG 24 1976

MISS. BD. OF WATER COMM.

If well telescopes please sketch and show depths.

GROUND LEVEL

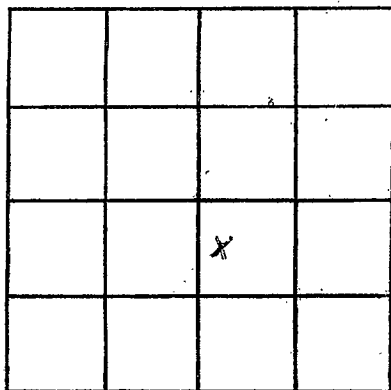

SECTION 20

Please indicate well location X.

ADDITIONAL INFORMATION

If more than one screen, show locations of each on sketch.