

WASHINGTON
A 1014,
4-8-77

MISSISSIPPI
BOARD OF WATER COMMISSIONERS
416 North State Street
151. Jackson, Mississippi 39201

WATER WELL DRILLERS LOG

4-8 1977 Bailey Drilling Co. Washington
date well completed firm name county well located

LANDOWNER: Stitt Farms

Box Winterville, MS

(mailing address)

WELL LOCATION:

sec. 19 T. 19 N R. 9 E
S W
3 miles West of Winterville
(distance) (direction) (nearest town)

WELL PURPOSE: farm & home
(home, irrigation, municipal, industrial)

WELL COMPLETION DATA:

- (1) diameter (inches) 4 X 2
- (2) total depth (feet) 481
- (3) static water level (feet) 70 below
top of ground. above
- (4) casing Steel, 463,
(material) (depth)
4 X 2 if telescope see back.
(size)
- (5) screen 18', 463
(length) (depth to top)
2", Stainless Steel
(size) (material)
- (6) pump 2 35
(HP) (yield gpm)
Elec
(type power)
- (7) electric log No
(yes or no)

(organization running log)

(8) how well bottom plugged:
back pressure valve

DRILLERS REMARKS:

description of formations encountered

from to


Clay	0	20
Sand	20	75
Gravel	75	105
Mud	105	285
Sand	285	320
Mud	320	410
Sand	410	481

RECEIVED
APR 13 1977

MISS. BD. OF WATER COMMISSIONERS

If well telescopes please sketch and show depths.

GROUND LEVEL

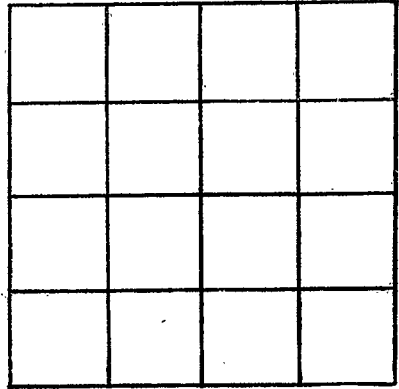

SECTION _____

Please indicate well location X.

ADDITIONAL INFORMATION

If more than one screen,
show locations of each on sketch.