

WASHINGTON

A 1015

MISSISSIPPI BOARD OF WATER COMMISSIONERS
416 North State Street
Jackson, Mississippi 39201

WATER WELL DRILLERS LOG

28 Mar 1978 Lambert Drilling Co Wash
date well completed firm name county well located

LANDOWNER:
Reed Hodge
Greenville Miss.
(mailing address)
WELL LOCATION:
sec. 32 T. 19 N. R. 9 E
10 miles N.W. of Greenville
(distance) (direction) (nearest town)

WELL PURPOSE: none
(home, irrigation, municipal, industrial)

- WELL COMPLETION DATA:
- (1) diameter (inches) 4x2
 - (2) total depth (feet) 534
 - (3) static water level (feet) 46 below top of ground.
 - (4) casing PVC 514 (material) (depth)
4x2 (size) If telescope see back.
 - (5) screen 20 534-514 (length) (depth to top)
2" PVC (size) (material)
 - (6) pump 1 20 (HP) (yield gpm)
elect (type power)
 - (7) electric log no (yes or no)

(organization running log)
(8) how well bottom plugged back wash

DRILLERS REMARKS:

description of formations encountered	from	to
mixed	0	15
Clay	15	30
Sand	30	60
sand & gravel	60	118
Clay	118	220
Clay & Sand	220	380
Sand. fine	380	490
Sand. good	490	534

RECEIVED
MAY 16 1978

MISS. BD. OF WATER COMMISSIONERS

If well telescopes please sketch and show depths.

GROUND LEVEL

140


411

514

211

534

210 WS

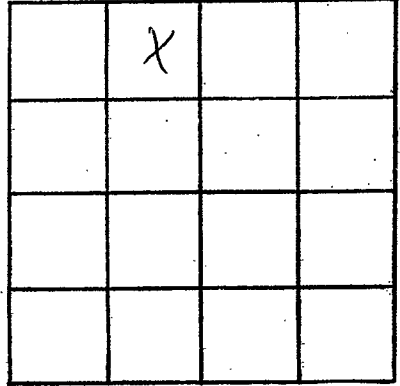

SECTION 32

Please indicate well location X.

ADDITIONAL INFORMATION

If more than one screen, show locations of each on sketch.