

WASHINGTON

A 1017

8-5-78

MISSISSIPPI BOARD OF WATER COMMISSIONERS  
416 North State Street  
Jackson, Mississippi 39201

WATER WELL DRILLERS LOG

5 Aug 1978 Lambert Drilling Wash date well completed firm name county well located

LANDOWNER:

Tommy McGehee  
Greenville, MISS.  
(mailing address)

description of formations encountered

from to

Clay 0 17

Sand 17 45

gravel 45 102

Clay 102 245

Clay st sand 245 360

Sand st clay 360 460

Sand 460 490

WELL LOCATION:

sec 29 T 19 N R 8 E  
3 miles N of Greenville  
(distance) (direction) (nearest town)

WELL PURPOSE: NIMC.  
(home, irrigation, municipal, industrial)


WELL COMPLETION DATA:

- (1) diameter (inches) 2
- (2) total depth (feet) 490
- (3) static water level (feet) 41 below above top of ground.
- (4) casing PVC 480 (material) (depth)  
2 (size) If telescope see back.
- (5) screen 10 390-480 (length) (depth to top)  
2 PVC (size) (material)
- (6) pump 1 (HP) 10 (yield gpm)  
elect (type power)
- (7) electric log no (yes or no)

(organization running log)

(8) how well bottom plugged back press.

DRILLERS REMARKS:

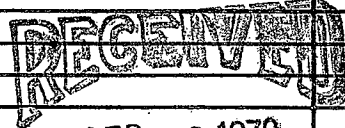

SEP - 8 1978

MISS. BD. OF WATER COMMISSIONERS

If well telescopes please sketch and show depths.

GROUND LEVEL

		X	

SECTION 29

Please indicate well location X.

ADDITIONAL INFORMATION

If more than one screen,  
show locations of each on sketch.